


These drawings are to be an instrument of service and shall remain the property of the Architect. They are not to be used on other projects or extensions to this project except by agreement in writing and with appropriate compensation to the Architect. Contractor is responsible for confirming and correlating dimensions at the job site; the Architect will not be responsible for construction means, methods, techniques, sequences or procedures, or for safety precautions and programs in connection with the project.

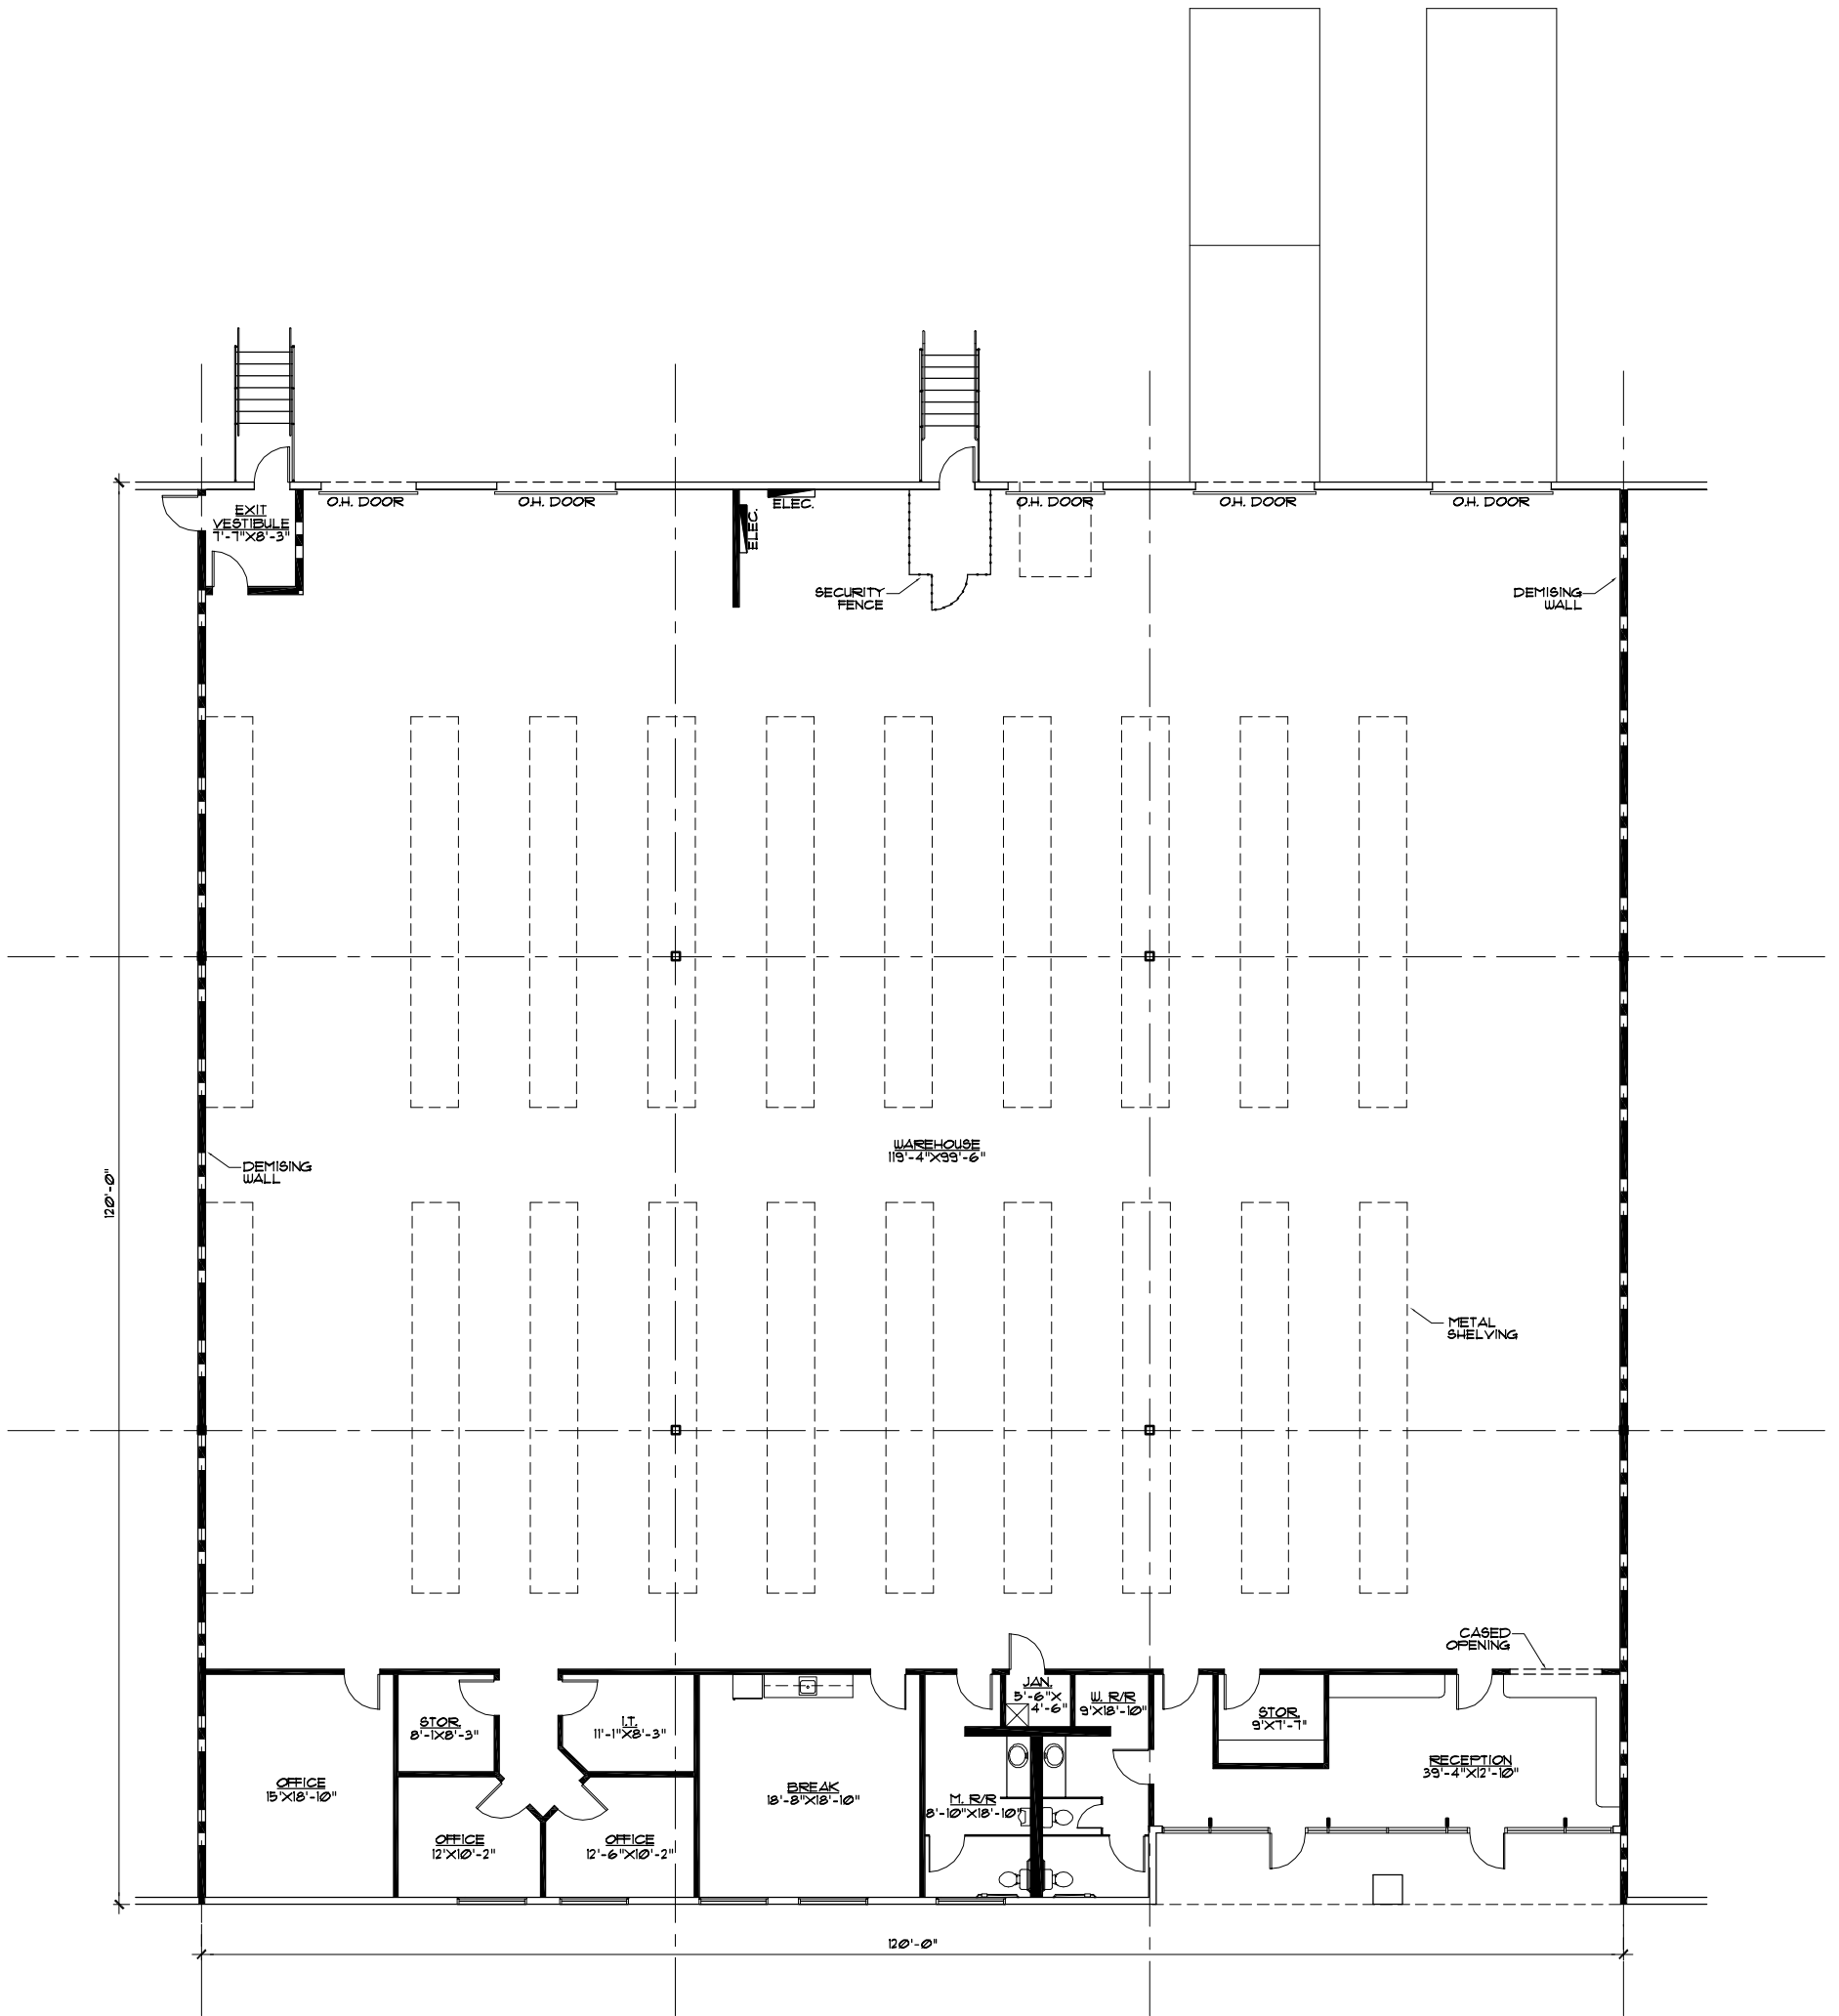

AS-BUILT FLOOR PLAN

SCALE: 1/16"=1'-0"

WAREHOUSE:	11,942 S.F.
OFFICE:	2,383 S.F.
COMMON AREA:	75 S.F.
OVERALL:	14,400 S.F.


SK1

DRAWN: JLC
 CHECKED: MDN
 DATE: 07/14/08
 PROJECT: 1211 ARION
 JOB NO.: 08-093
 SHEET

ARCHITECTURAL SURVEY

1211 ARION PKWY. STE. 112
 SAN ANTONIO, TEXAS

NOT FOR REGULATORY APPROVAL,
 PERMITTING, OR CONSTRUCTION

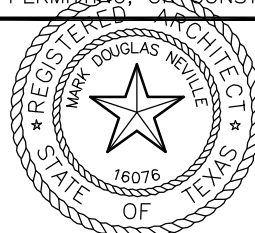

VILLA PARK

ARCHITECTURE/PLANNING/INTERIORS
 2553 JACKSON KELLER, SUITE 1 VOICE: (210) 384-8900
 SAN ANTONIO, TX. 78230 FAX: (210) 384-8240

© 2008 ALL RIGHTS RESERVED