




VILLA PARK
ARCHITECTURE/PLANNING/INTERIORS

2553 JACKSON KELLER, SUITE 1
SAN ANTONIO, TX 78230
VOICE: (210) 384-8900
FAX: (210) 384-8240


© 2009 ALL RIGHTS RESERVED

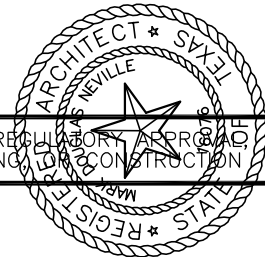

NOT FOR REGULATION APPROVAL
PERMITTING OR CONSTRUCTION

AS BUILT LEASE PLAN

**12005 STARCREST
BLOSSOM BUSINESS PARK
SAN ANTONIO, TEXAS**

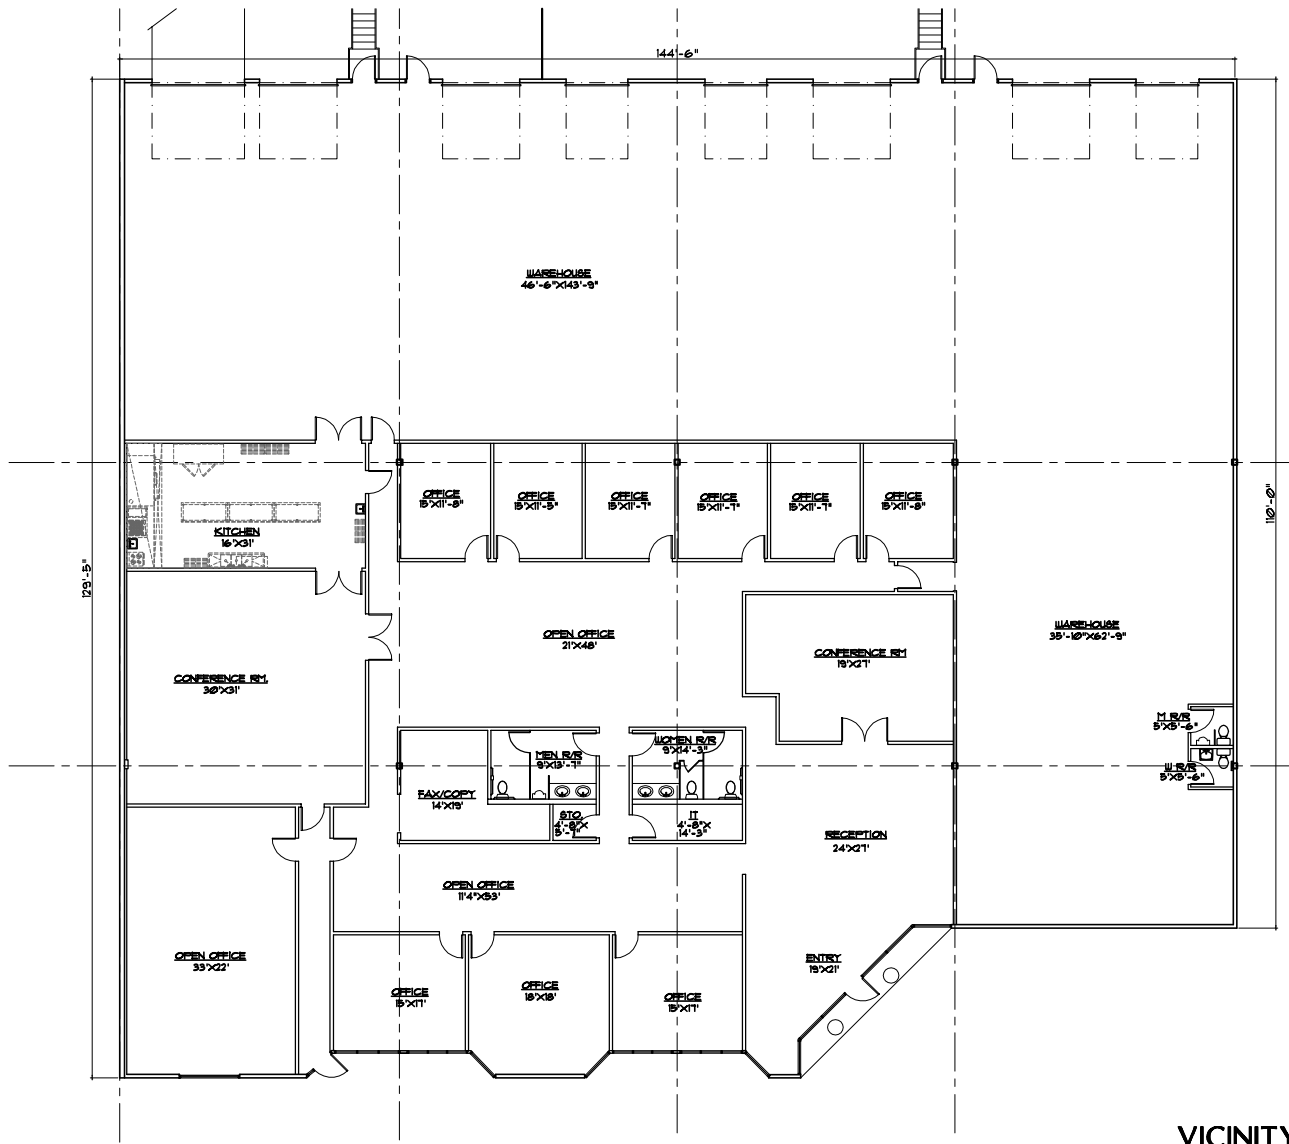


LEASE PLAN

SCALE: N.T.S.

OFFICE: 8,720 S.F.
TOTAL: 17,800 S.F.

VICINITY MAP

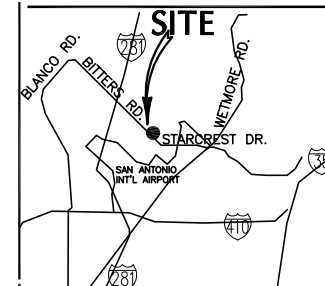

DRAWN AEV	PROJECT 12005 STARCREST
CHECKED MDN	JOB. NO. 09-156
DATE 100109	

SHEET

AB1