


THESE DRAWINGS ARE THE PROPERTY OF VILLA PARK ARCHITECTURE/PLANNING/INTERIORS. THEY ARE TO BE USED ONLY FOR THE PROJECT AND SITE SPECIFICALLY IDENTIFIED. ANY REUSE, REPRODUCTION, OR ALTERATION OF THESE DRAWINGS WITHOUT THE WRITTEN PERMISSION OF VILLA PARK ARCHITECTURE/PLANNING/INTERIORS IS STRICTLY PROHIBITED. THE ARCHITECT ASSUMES NO LIABILITY FOR CONSTRUCTION METHODS, MATERIALS, OR THE SAFETY, PERFORMANCE AND PROGRAMS IN CONNECTION WITH THIS PROJECT.

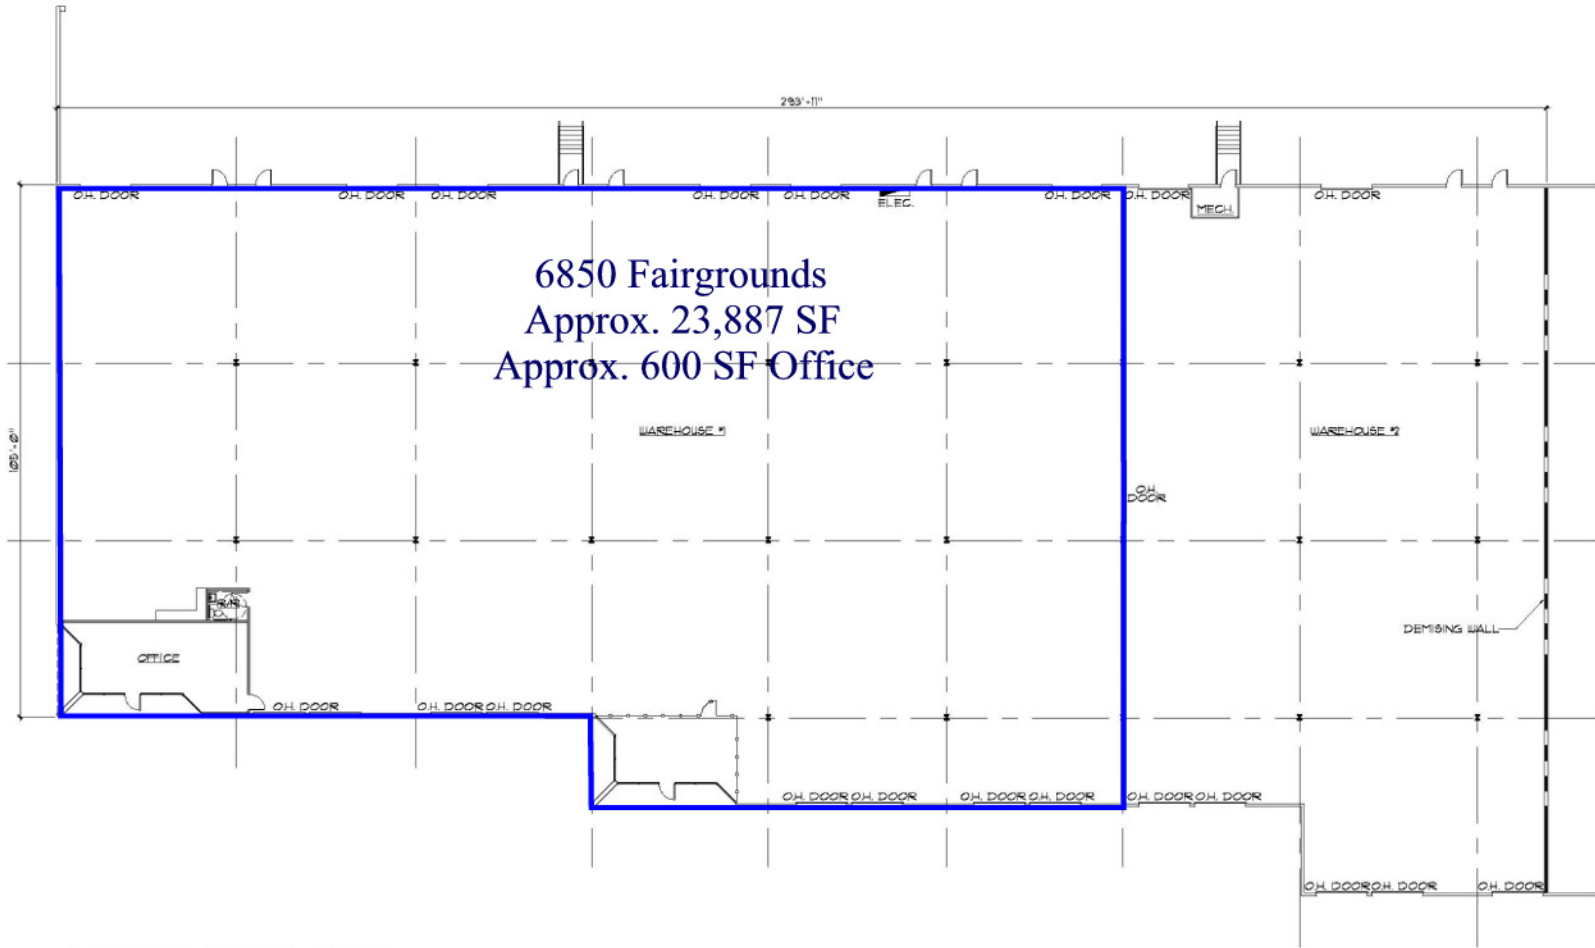

AS-BUILT FLOOR PLAN
SCALE: N.T.S.


VILLA PARK
 ARCHITECTURE/PLANNING/INTERIORS
 2333 JACKSON KELLER, SUITE 1 VOICE: (710) 344-8900
 SAN ANTONIO, TX, 78220 FAX: (210) 344-8240
 © 2008 ALL RIGHTS RESERVED



AS-BUILT FLOOR PLAN
6850 FAIRGROUNDS PKWY.
SAN ANTONIO, TEXAS

DRAWN
JLC
CHECKED
MB
DATE
09/04/08
PROJECT
6850 FAIRGROUNDS
JOB NO.
08-103
SHEET

SK1