
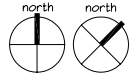


NOT FOR
REGULATORY
APPROVAL,
PERMITTING, OR
CONSTRUCTION

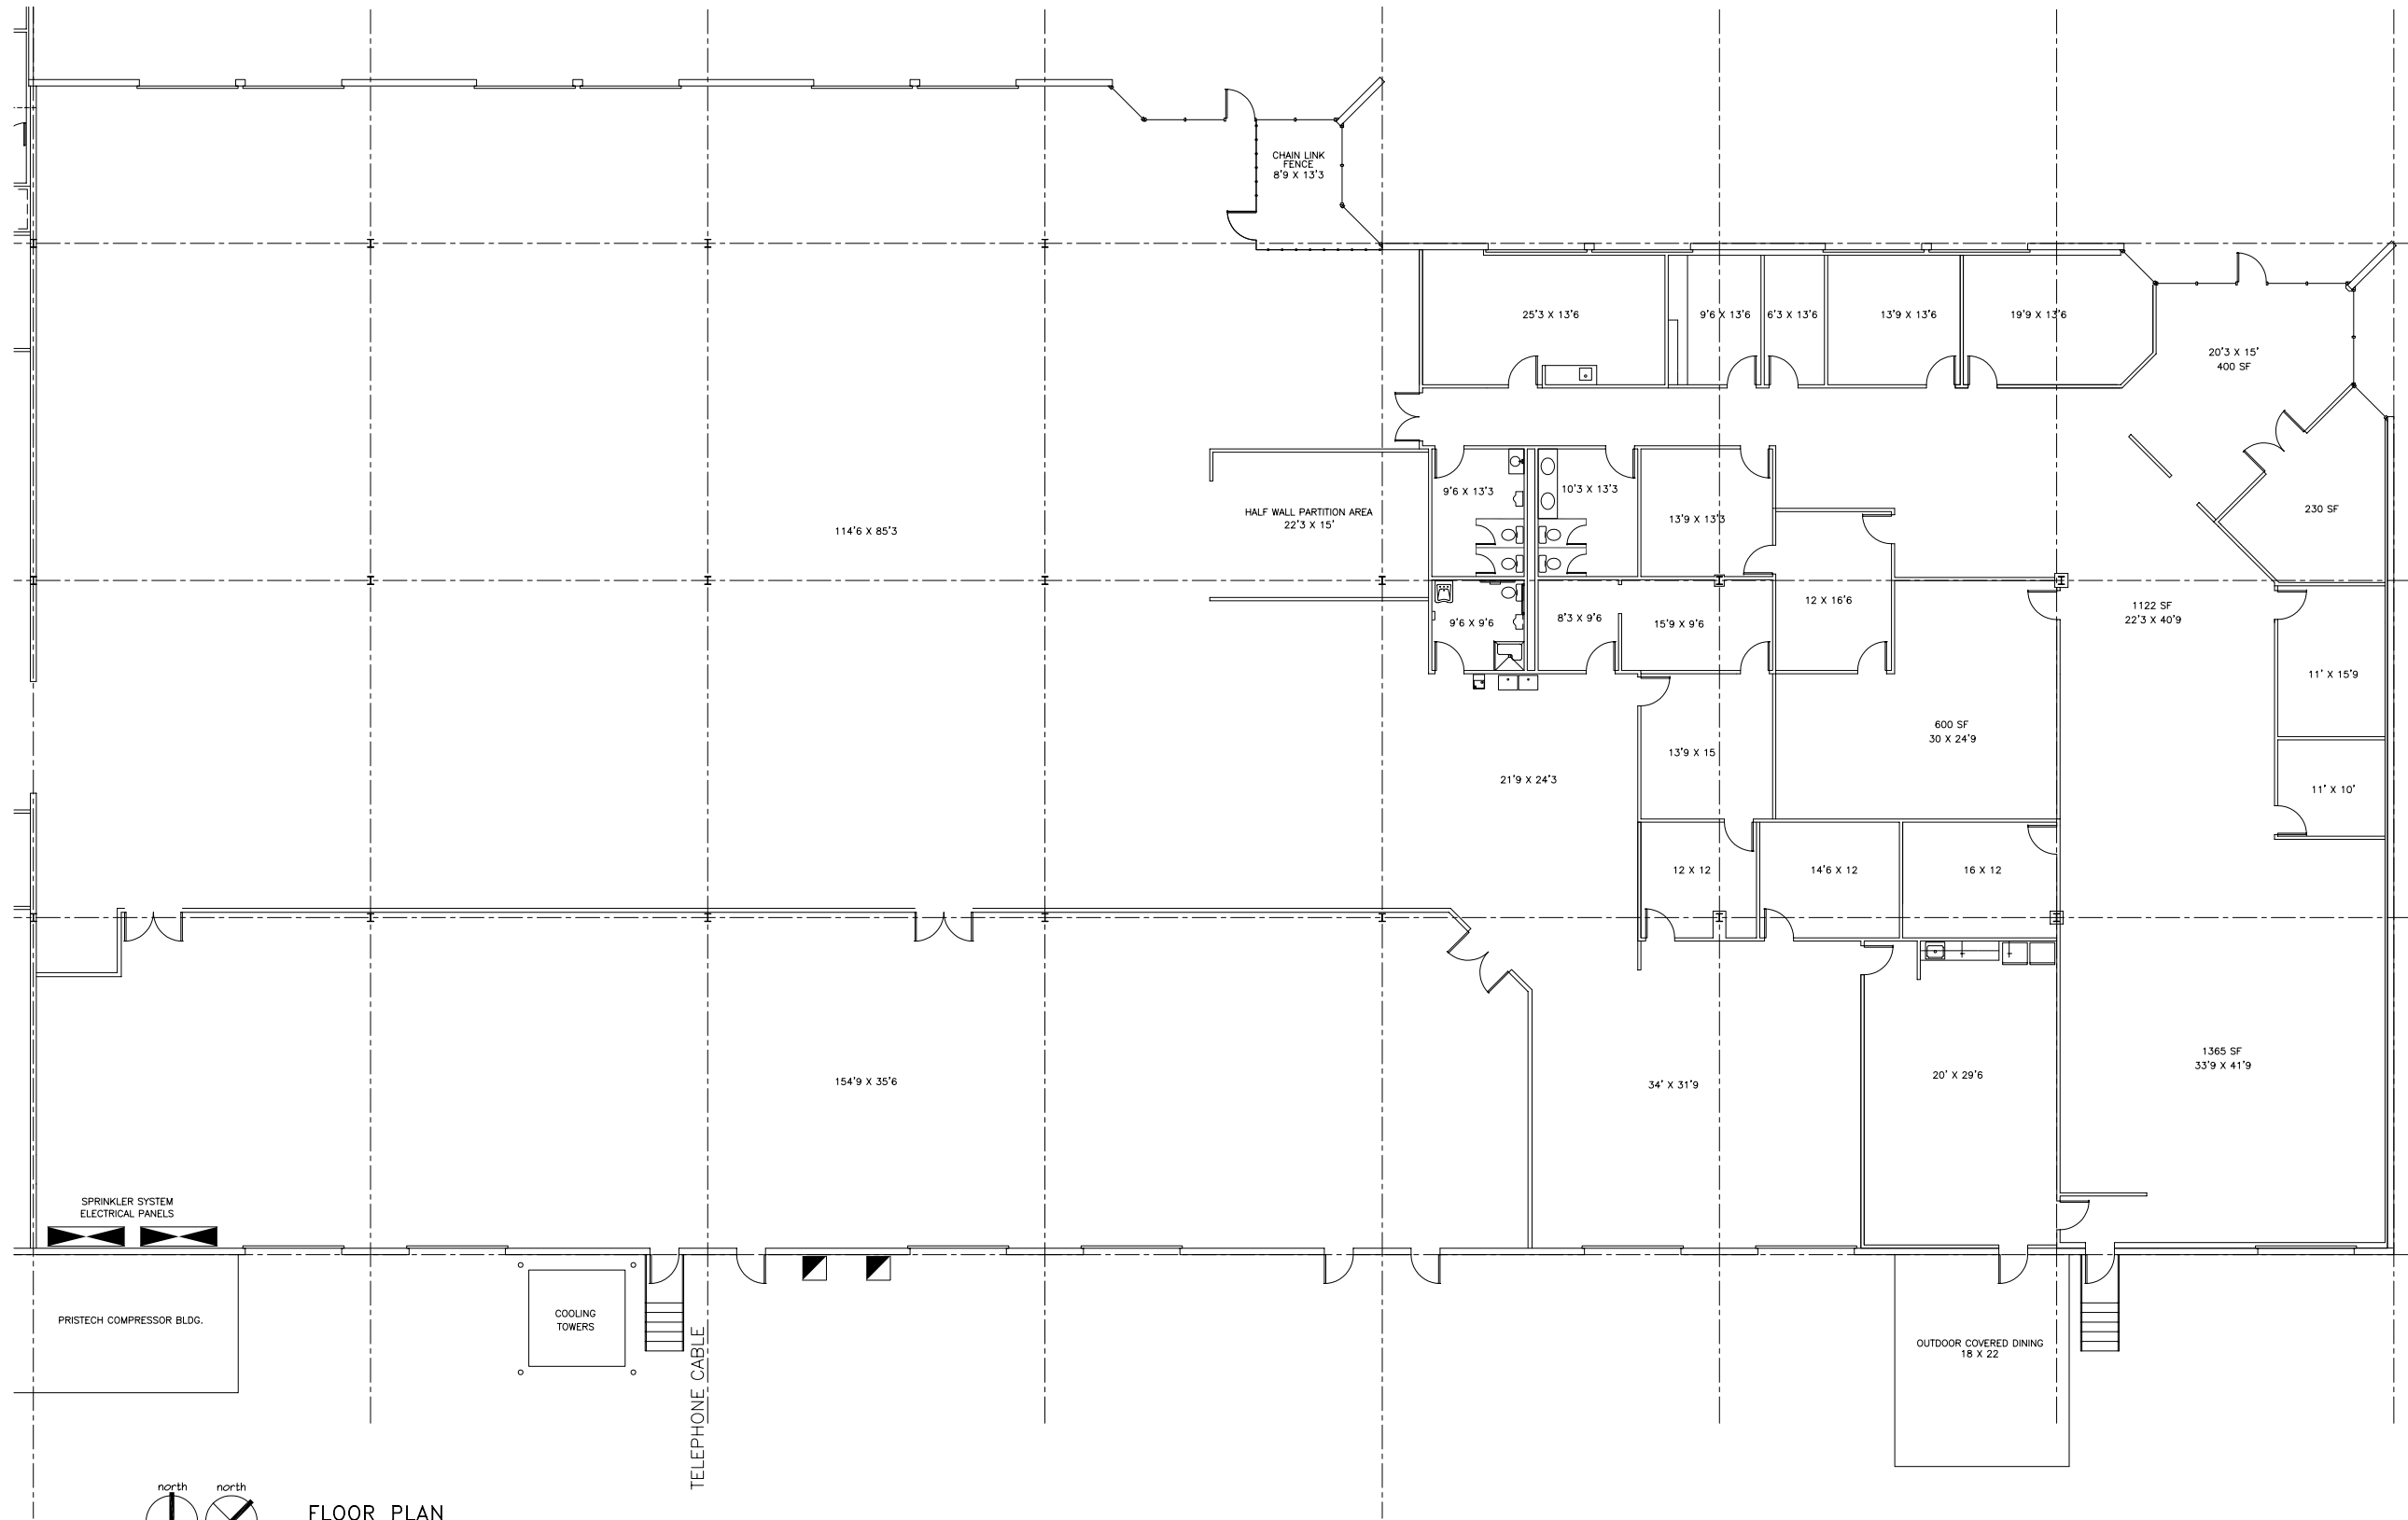

FLOOR PLAN

1/8" = 1'-0"

BUILDING 1
OFFICE: 8,477 S.F.
WARHOUSE: 19,911 S.F.
TOTAL: 28,388 S.F.

R.L. Worth & Associates, Ltd.
 4040 Broadway, Suite 522
 San Antonio, Texas 78209
 Telephone: (210) 822-5220
 Facsimile: (210) 822-5224

RECORD DRAWING
 BUILDING 1, SUITE 100

FAIRGROUNDS BUSINESS CENTER
 6952 Fairgrounds Pkwy
 San Antonio, Texas 78238

Project: 220505
 Date: 03-31-06
 Revised:

BUILDING 1
RD