


These drawings are to be an instrument of service and shall remain the property of the Architect. They are not to be used on other projects or extensions to this project except by agreement in writing and with appropriate compensation to the Architect. Contractor is responsible for confirming and correlating dimensions at the job site; the Architect will not be responsible for construction means, methods, techniques, sequences or procedures, or for safety precautions and programs in connection with the project.

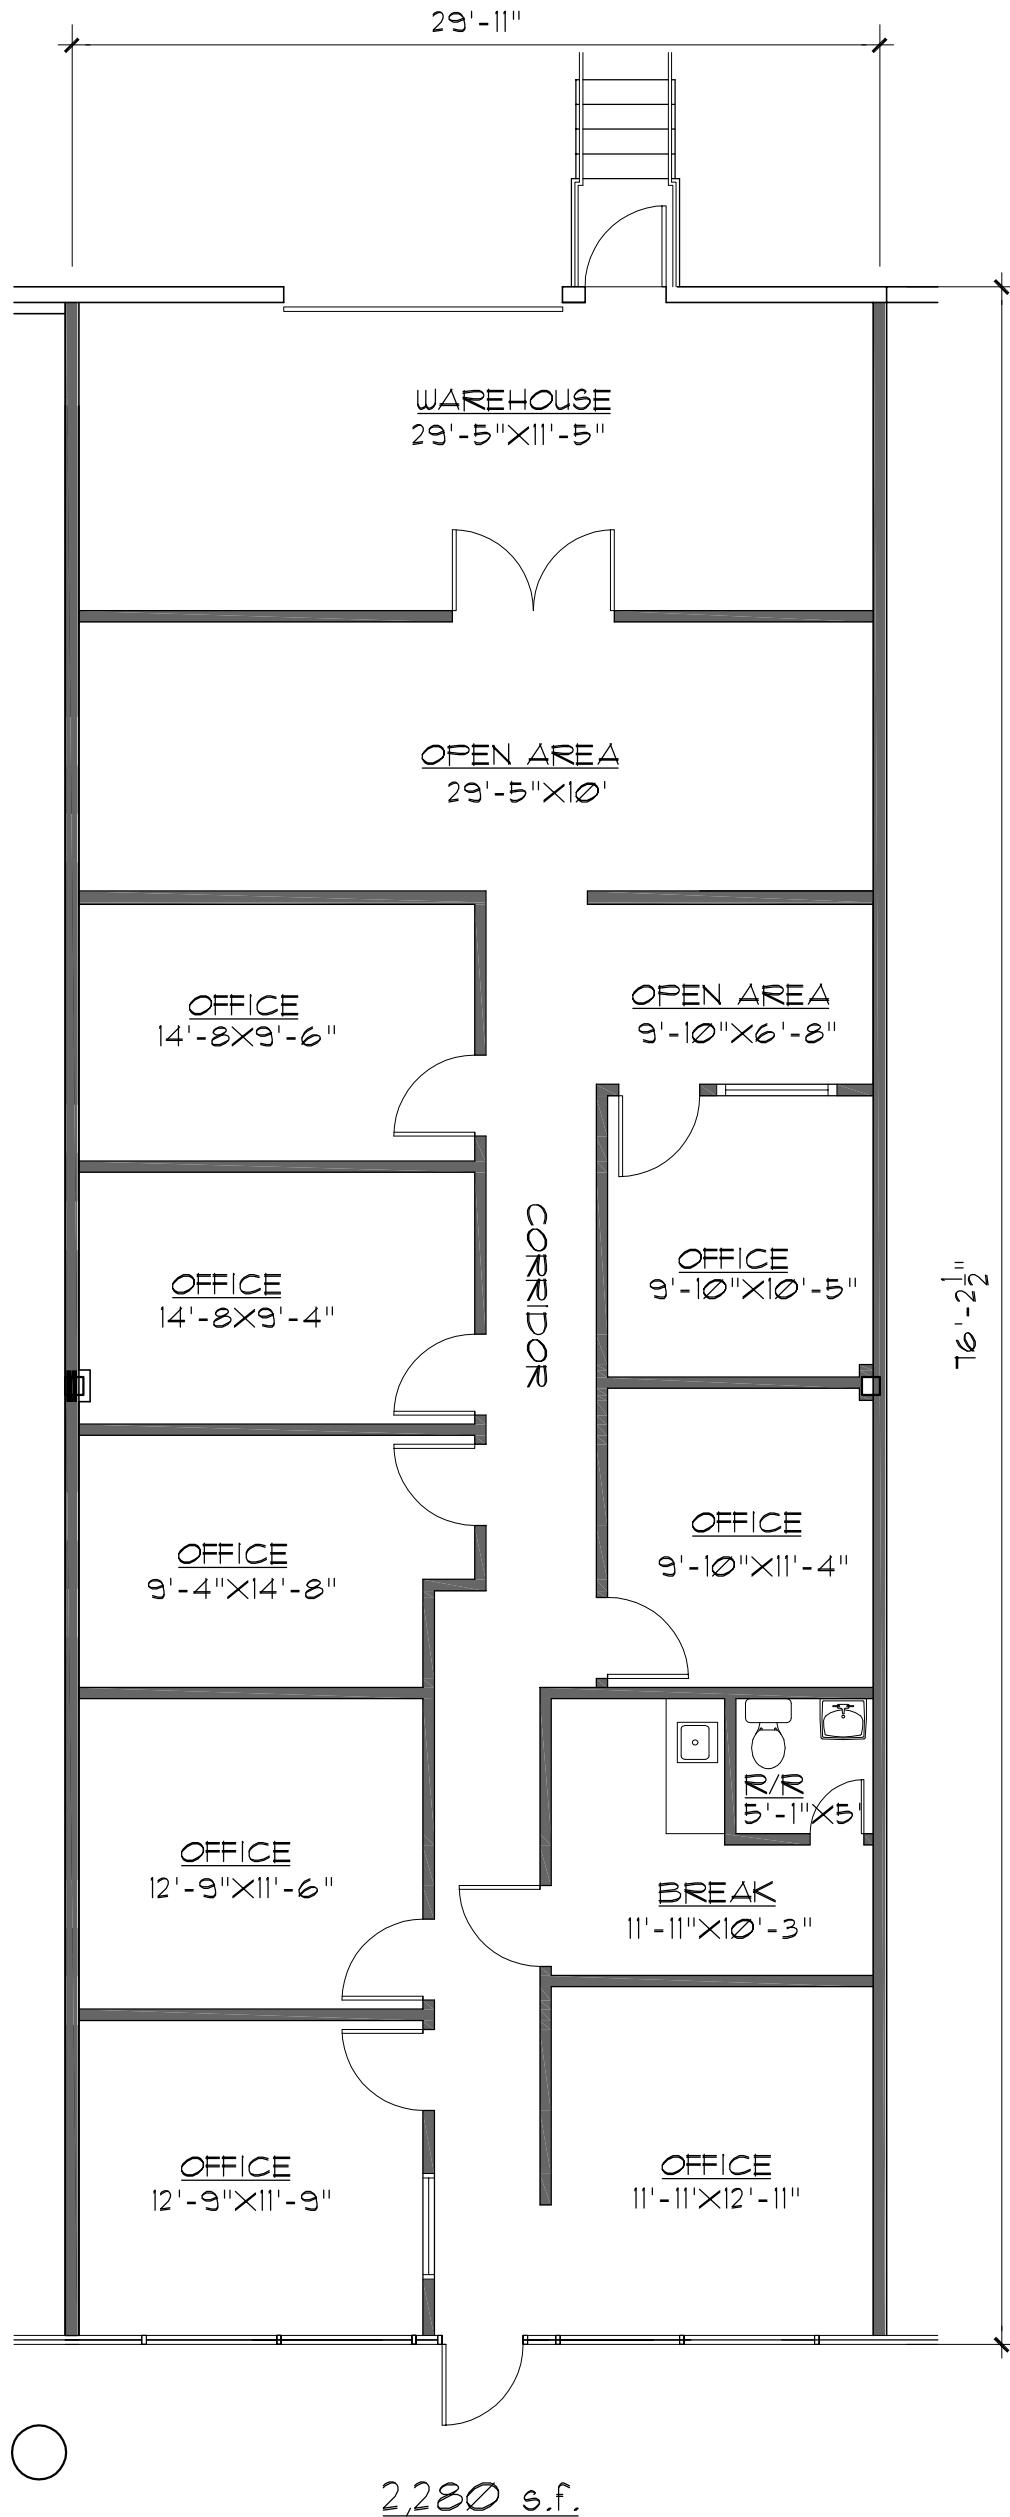

AS-BUILT FLOOR PLAN

SCALE: N.T.S.

SK1

DRAWN
AEV

CHECKED
MDN

DATE
10/05/08

PROJECT
4768 RESEARCH


JOB. NO.
08-146

SHEET

ARCHITECTURAL SURVEY

4768 RESEARCH DRIVE
SAN ANTONIO, TEXAS

NOT FOR REGULATORY APPROVAL,
PERMITTING OR CONSTRUCTION

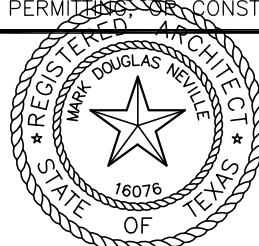

VILLA PARK

ARCHITECTURE/PLANNING/INTERIORS
2553 JACKSON KELLER, SUITE 1 VOICE: (210) 384-8900
SAN ANTONIO, TX. 78230 FAX: (210) 384-8240

© 2008 ALL RIGHTS RESERVED