


DRAWN	AEV
CHECKED	MDN
DATE	09/29/14
PROJECT	1874 GRANDSTAND
JOB. NO.	14-261
SHEET	

AB1



LEASE AREA:	
OFFICE:	1,494 S.F.
WAREHOUSE:	1,175 S.F.
TOTAL:	2,669 S.F.

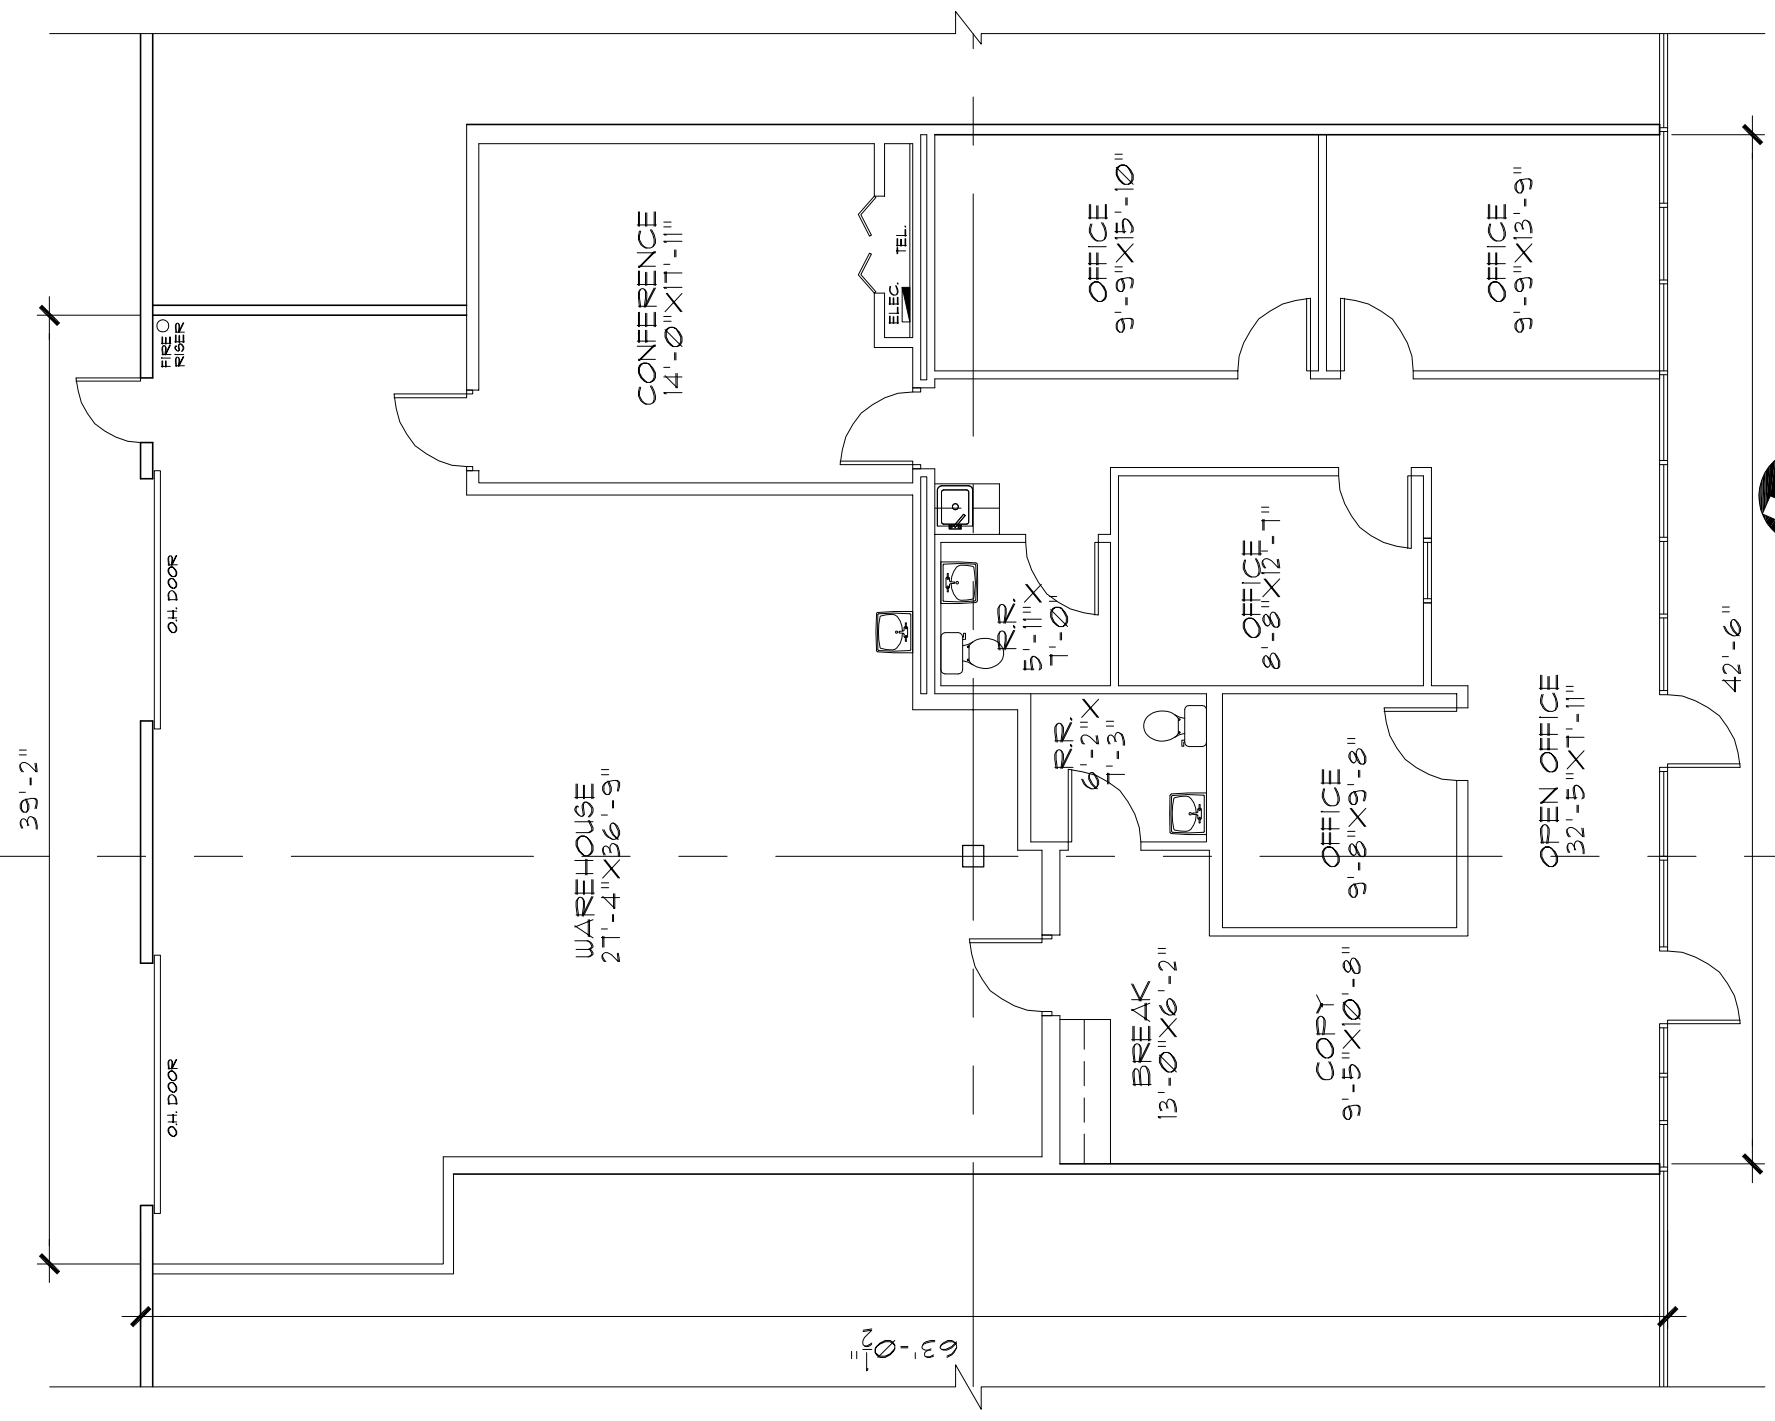

AS-BUILT FLOOR PLAN 2,669 S.F.
 SCALE: 1/8"=1'-0"

NOTE: ALL DIMENSIONS ARE APPROXIMATE AND ALL INFORMATION IS OF GENERAL NATURE