


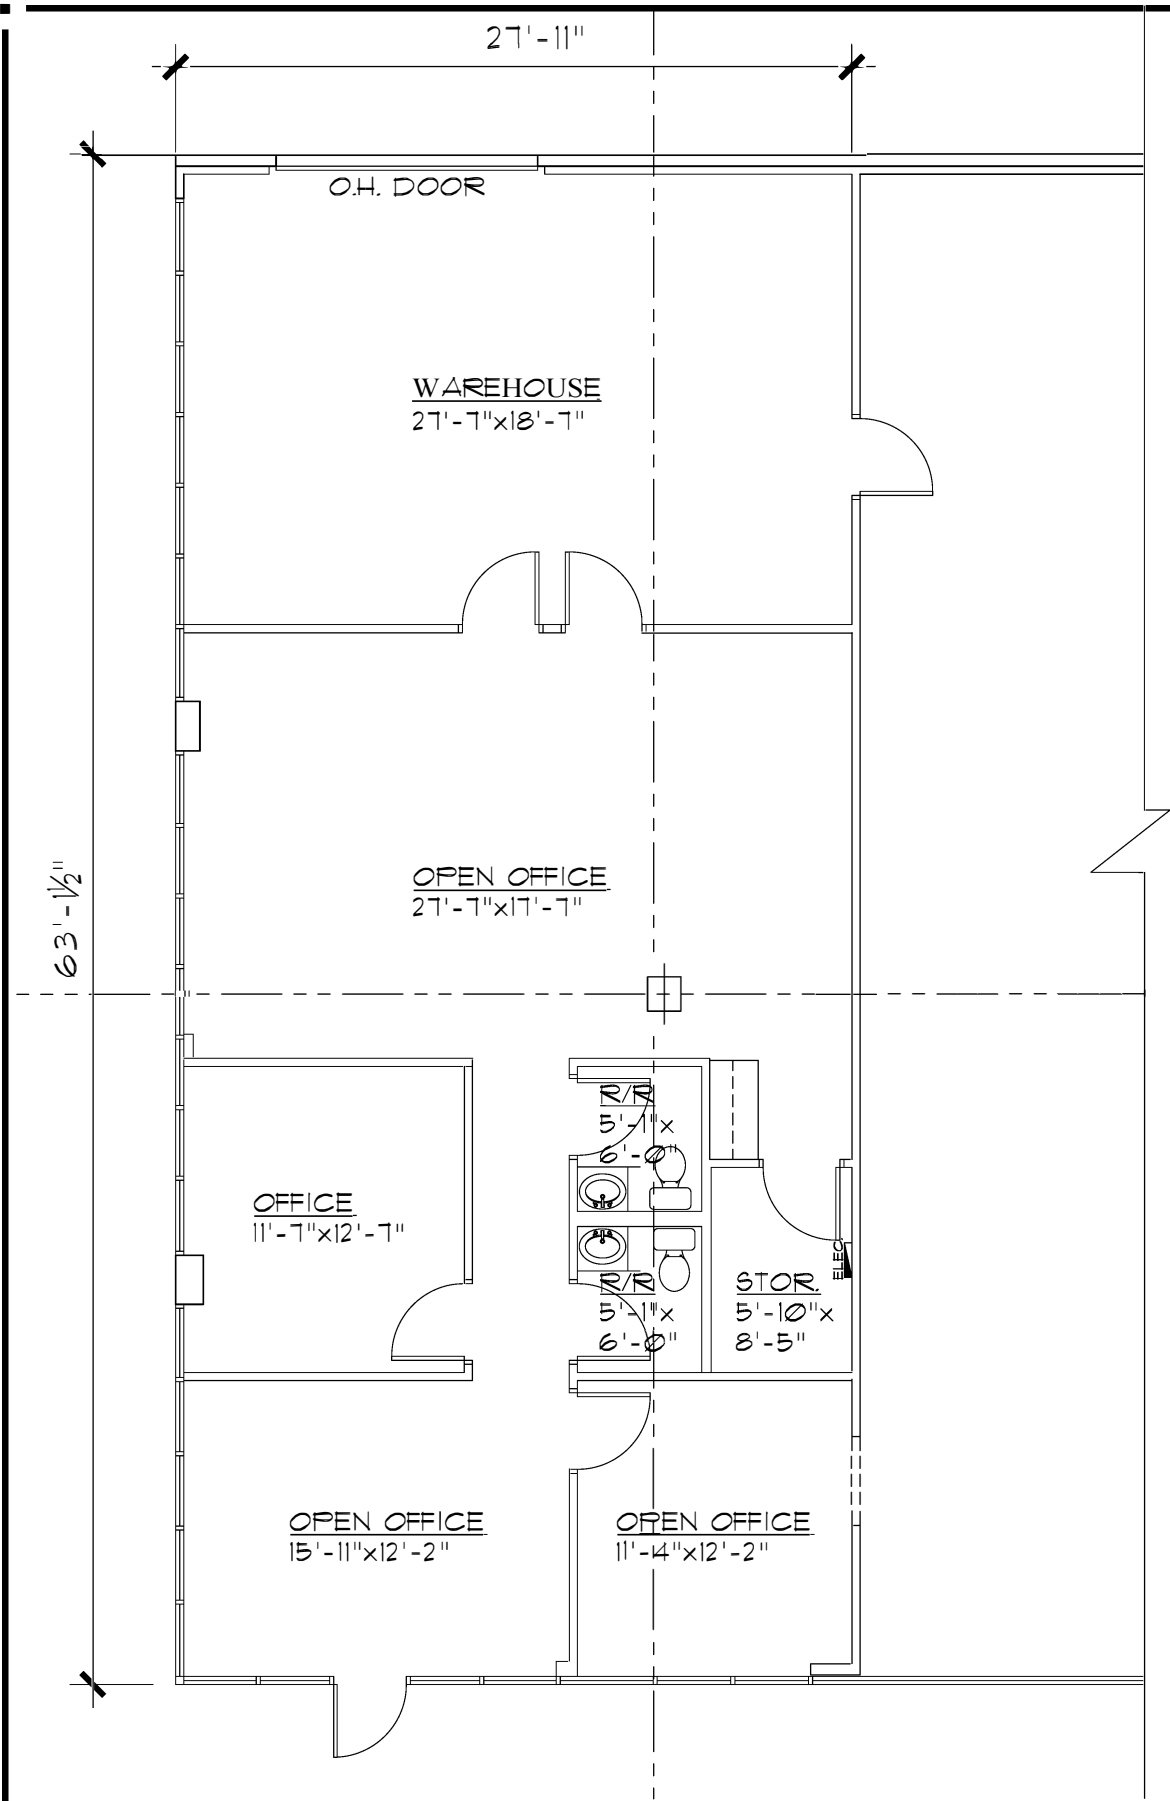

AS-BUILT FLOOR PLAN-1,776 S.F.

SCALE: 1/8"=1'-0"


NOTE: ALL DIMENSIONS ARE APPROXIMATE AND ALL INFORMATION IS OF GENERAL NATURE



VILLA PARK

ARCHITECTURE/PLANNING/INTERIORS PLLC
300 W. BITTERS ROAD, SUITE 204 VOICE: (210) 384-8900
SAN ANTONIO, TX. 78216 FAX: (210) 384-8240

© 2014 ALL RIGHTS RESERVED

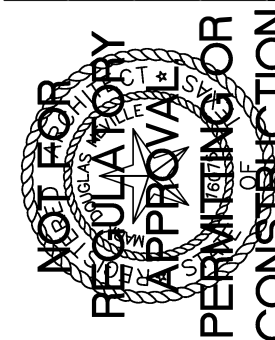

AS-BUILT FLOOR PLAN

NORTHWEST BUSINESS CENTER
1900 GRANDSTAND DRIVE
SAN ANTONIO, TX 78238

DRAWN
BKT

CHECKED
MDN

DATE
05/18/20

PROJECT
1900 GRANDSTAND

JOB. NO.
14-260

SHEET

AB1