


01 AS-BUILT FLOOR PLAN SUITE 408 - SUITE 3,041 S.F.

SCALE: GRAPHIC

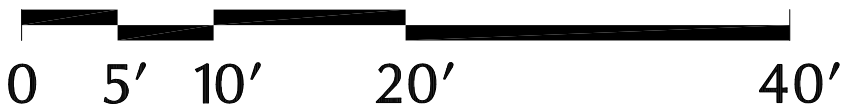

LEASE AREA:

OFFICE:	1,448 S.F.
WAREHOUSE:	1,593 S.F.
TOTAL:	3,041 S.F.

NOTE:

The measurements taken are within acceptable variances as subject to field conditions and tape measure variables. Therefore it is our opinion that the measurement reflect as built conditions. Note; Villa Park Architecture is not a Civil or Surveying company and therefore have limited capability to perform digitally verified information.

AB2-101222

AB2

DRAWN: SIM
 CHECKED: MON
 DATE: 10/22/22
 PROJECT: 5409 BANDERA SUITE 408
 JOB NO.: 22-242
 SHEET:

**AS-BUILT FLOOR PLAN
 SUITE 408**

5413 BANDERA RD.
 LEON VALLEY, TEXAS 78238



VILLA PARK
 ARCHITECTURE/PLANNING/INTERIORS, PLLC
 PH. (210) 384-8900
 © 2022 ALL RIGHTS RESERVED