


01 AS-BUILT FLOOR PLAN SUITE 501 - 4,025 S.F.

SCALE: GRAPHIC

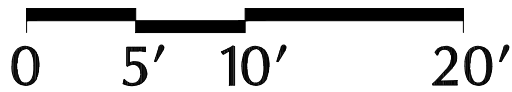

NORTH



AB1-042922

NOTE:

The measurements taken are within acceptable variances as subject to field conditions and tape measure variables. Therefore it is our opinion that the measurement reflect as built conditions. Note; Villa PaK Architecture is not a Civil or Surveying company and therefore have limited capability to perform digitally verified information.

| | |
|------------------------|---------|
| AB1 | DRAWN |
| | TH |
| | CHECKED |
| | DATE |
| | PROJECT |
| 5415 BANDERA SUITE 606 | |
| JOB NO. | |
| 22-030 | |
| SHEET | |

**AS-BUILT FLOOR PLAN
SUITE 501**

5415 BANDERA RD.
LEON VALLEY, TEXAS 78238



VILLA PARK
ARCHITECTURE/PLANNING/INTERIORS, PLLC
PH. (210) 384-8900
© 2022 ALL RIGHTS RESERVED