


01 AS-BUILT FLOOR PLAN
 SCALE: 1/16"=1'-0"
 NORTH

ALL DIMENSIONS ARE APPROXIMATE AND ALL INFORMATION IS OF GENERAL NATURE

AB1-060117

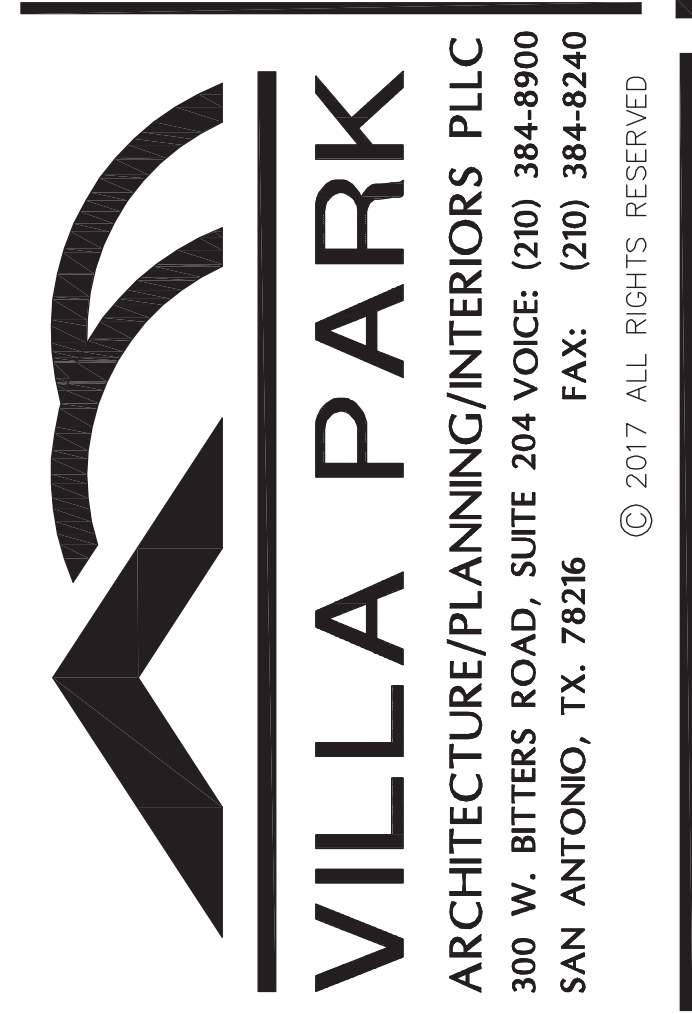

AS-BUILT FLOOR PLAN
 1014-1020 PAULSUN DRIVE
 SAN ANTONIO, TX 78219

DRAWN	NPS
CHECKED	MDN
DATE	06/01/17
PROJECT	1020 PAULSUN
JOB. NO.	16-022
SHEET	

AB1