


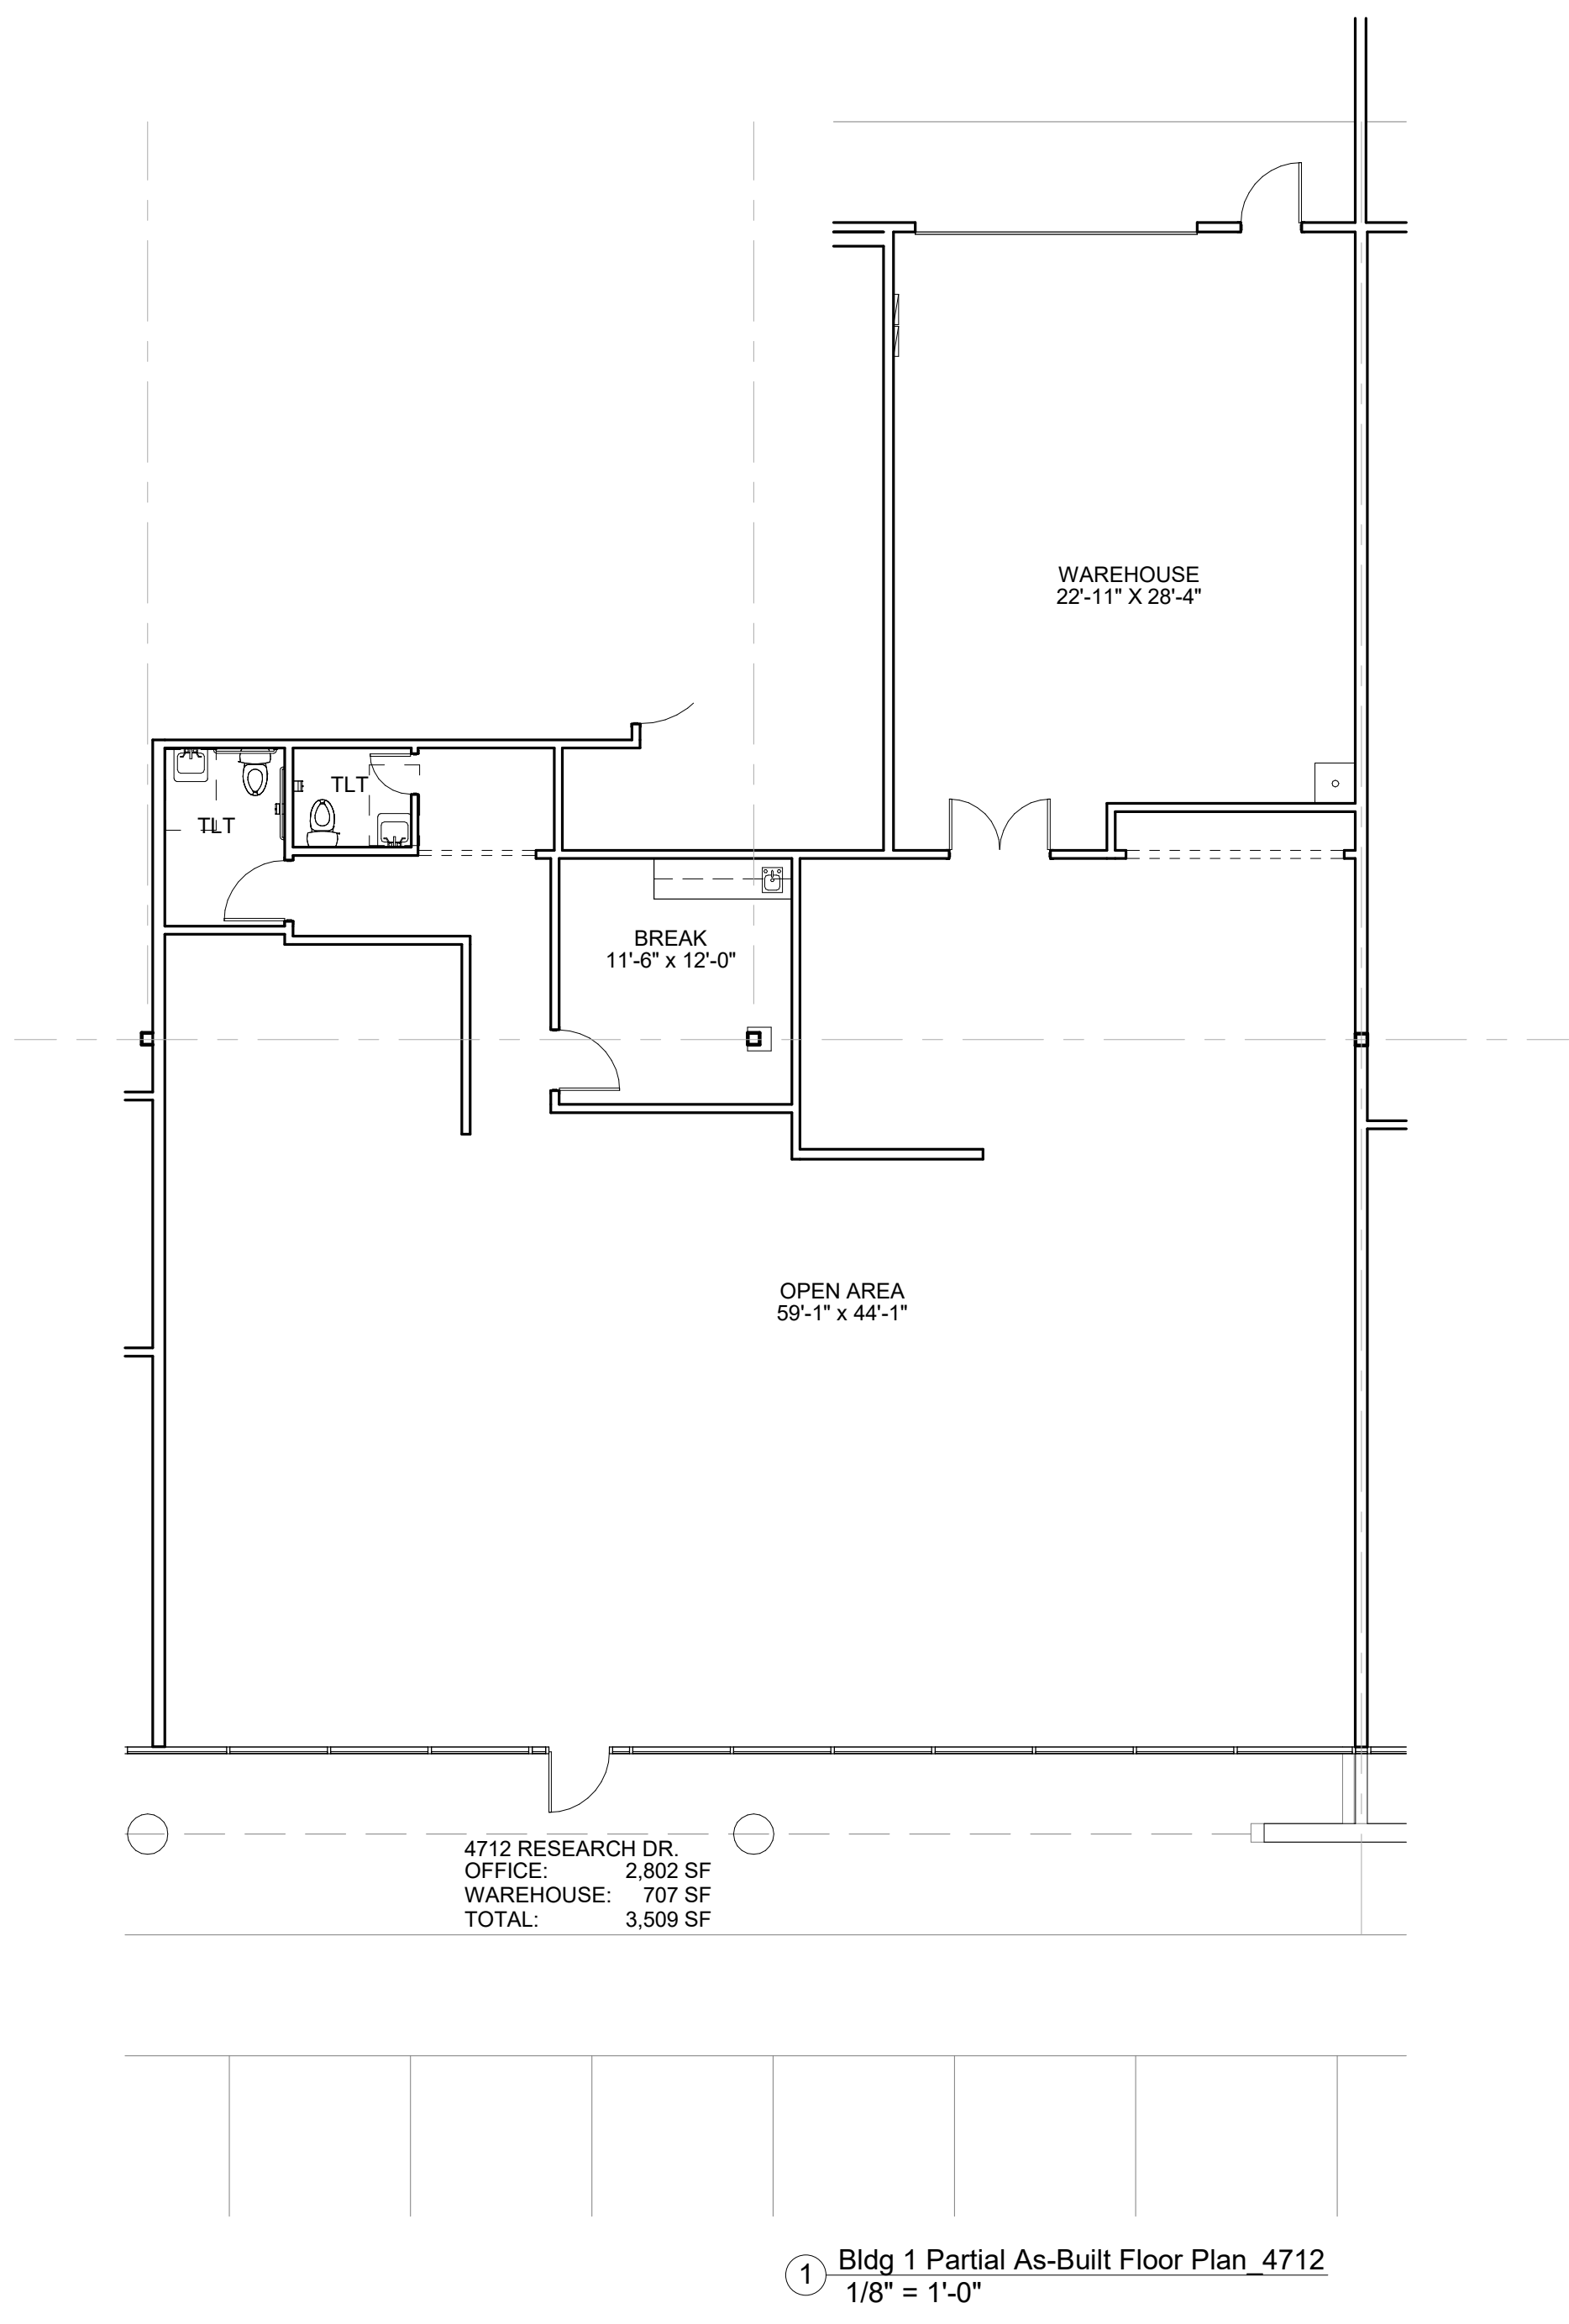

Bldg 1 - Northwest Corporate Center - Partial As-Built Floor Plan

Research Drive, San Antonio, Tx.

Scale: 1/8" = 1'-0"