


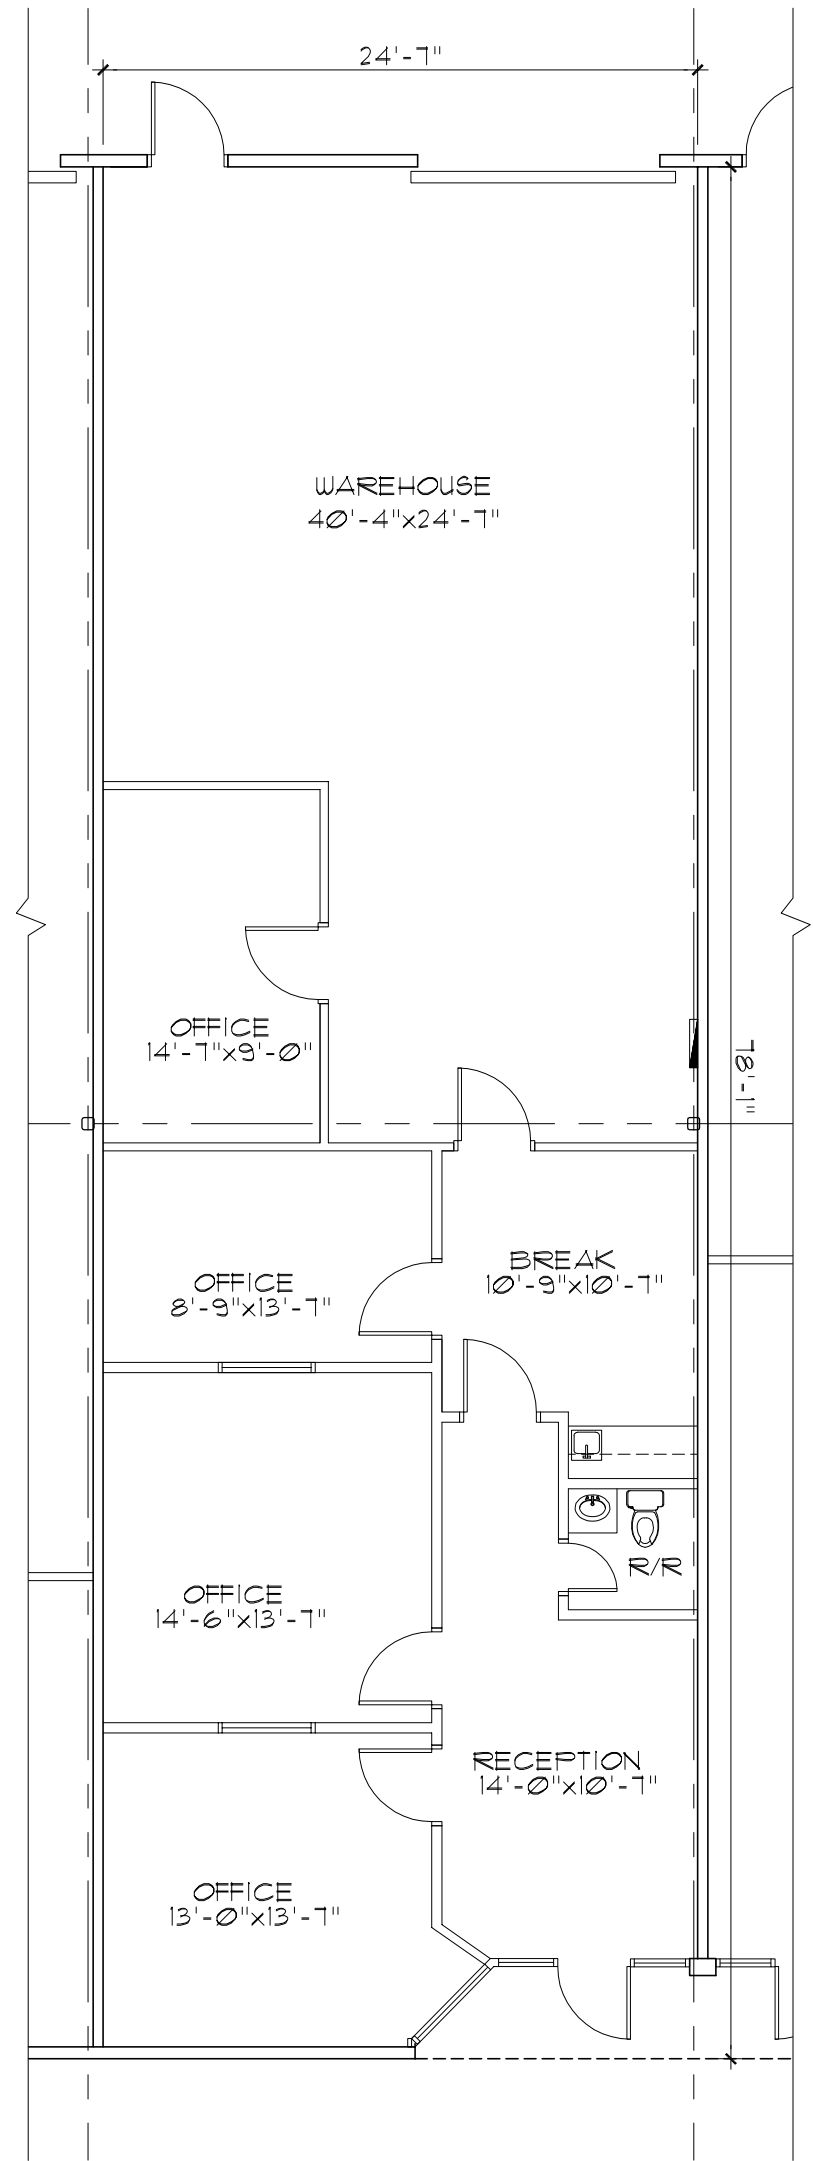

01 **AS-BUILT FLOOR PLAN**
SCALE: 1/8"=1'-0"

LEASE AREA:	
OFFICE:	1,087 S.F.
WAREHOUSE:	913 S.F.
TOTAL:	2,000 S.F.

ALL DIMENSIONS ARE APPROXIMATE AND ALL INFORMATION IS OF GENERAL NATURE

AB1-052616

AB1

DRAWN
NPS
CHECKED
MDN
DATE
05/26/16
PROJECT
12067 STARCREST
JOB. NO.
16-135
SHEET

AS-BUILT FLOOR PLAN

12067 STARCREST DR.
SAN ANTONIO, TX 78247



VILLA PARK

ARCHITECTURE/PLANNING/INTERIORS PLLC
300 W. BITTERS ROAD, SUITE 204 VOICE: (210) 384-8900
SAN ANTONIO, TX. 78216 FAX: (210) 384-8240

© 2015 ALL RIGHTS RESERVED