


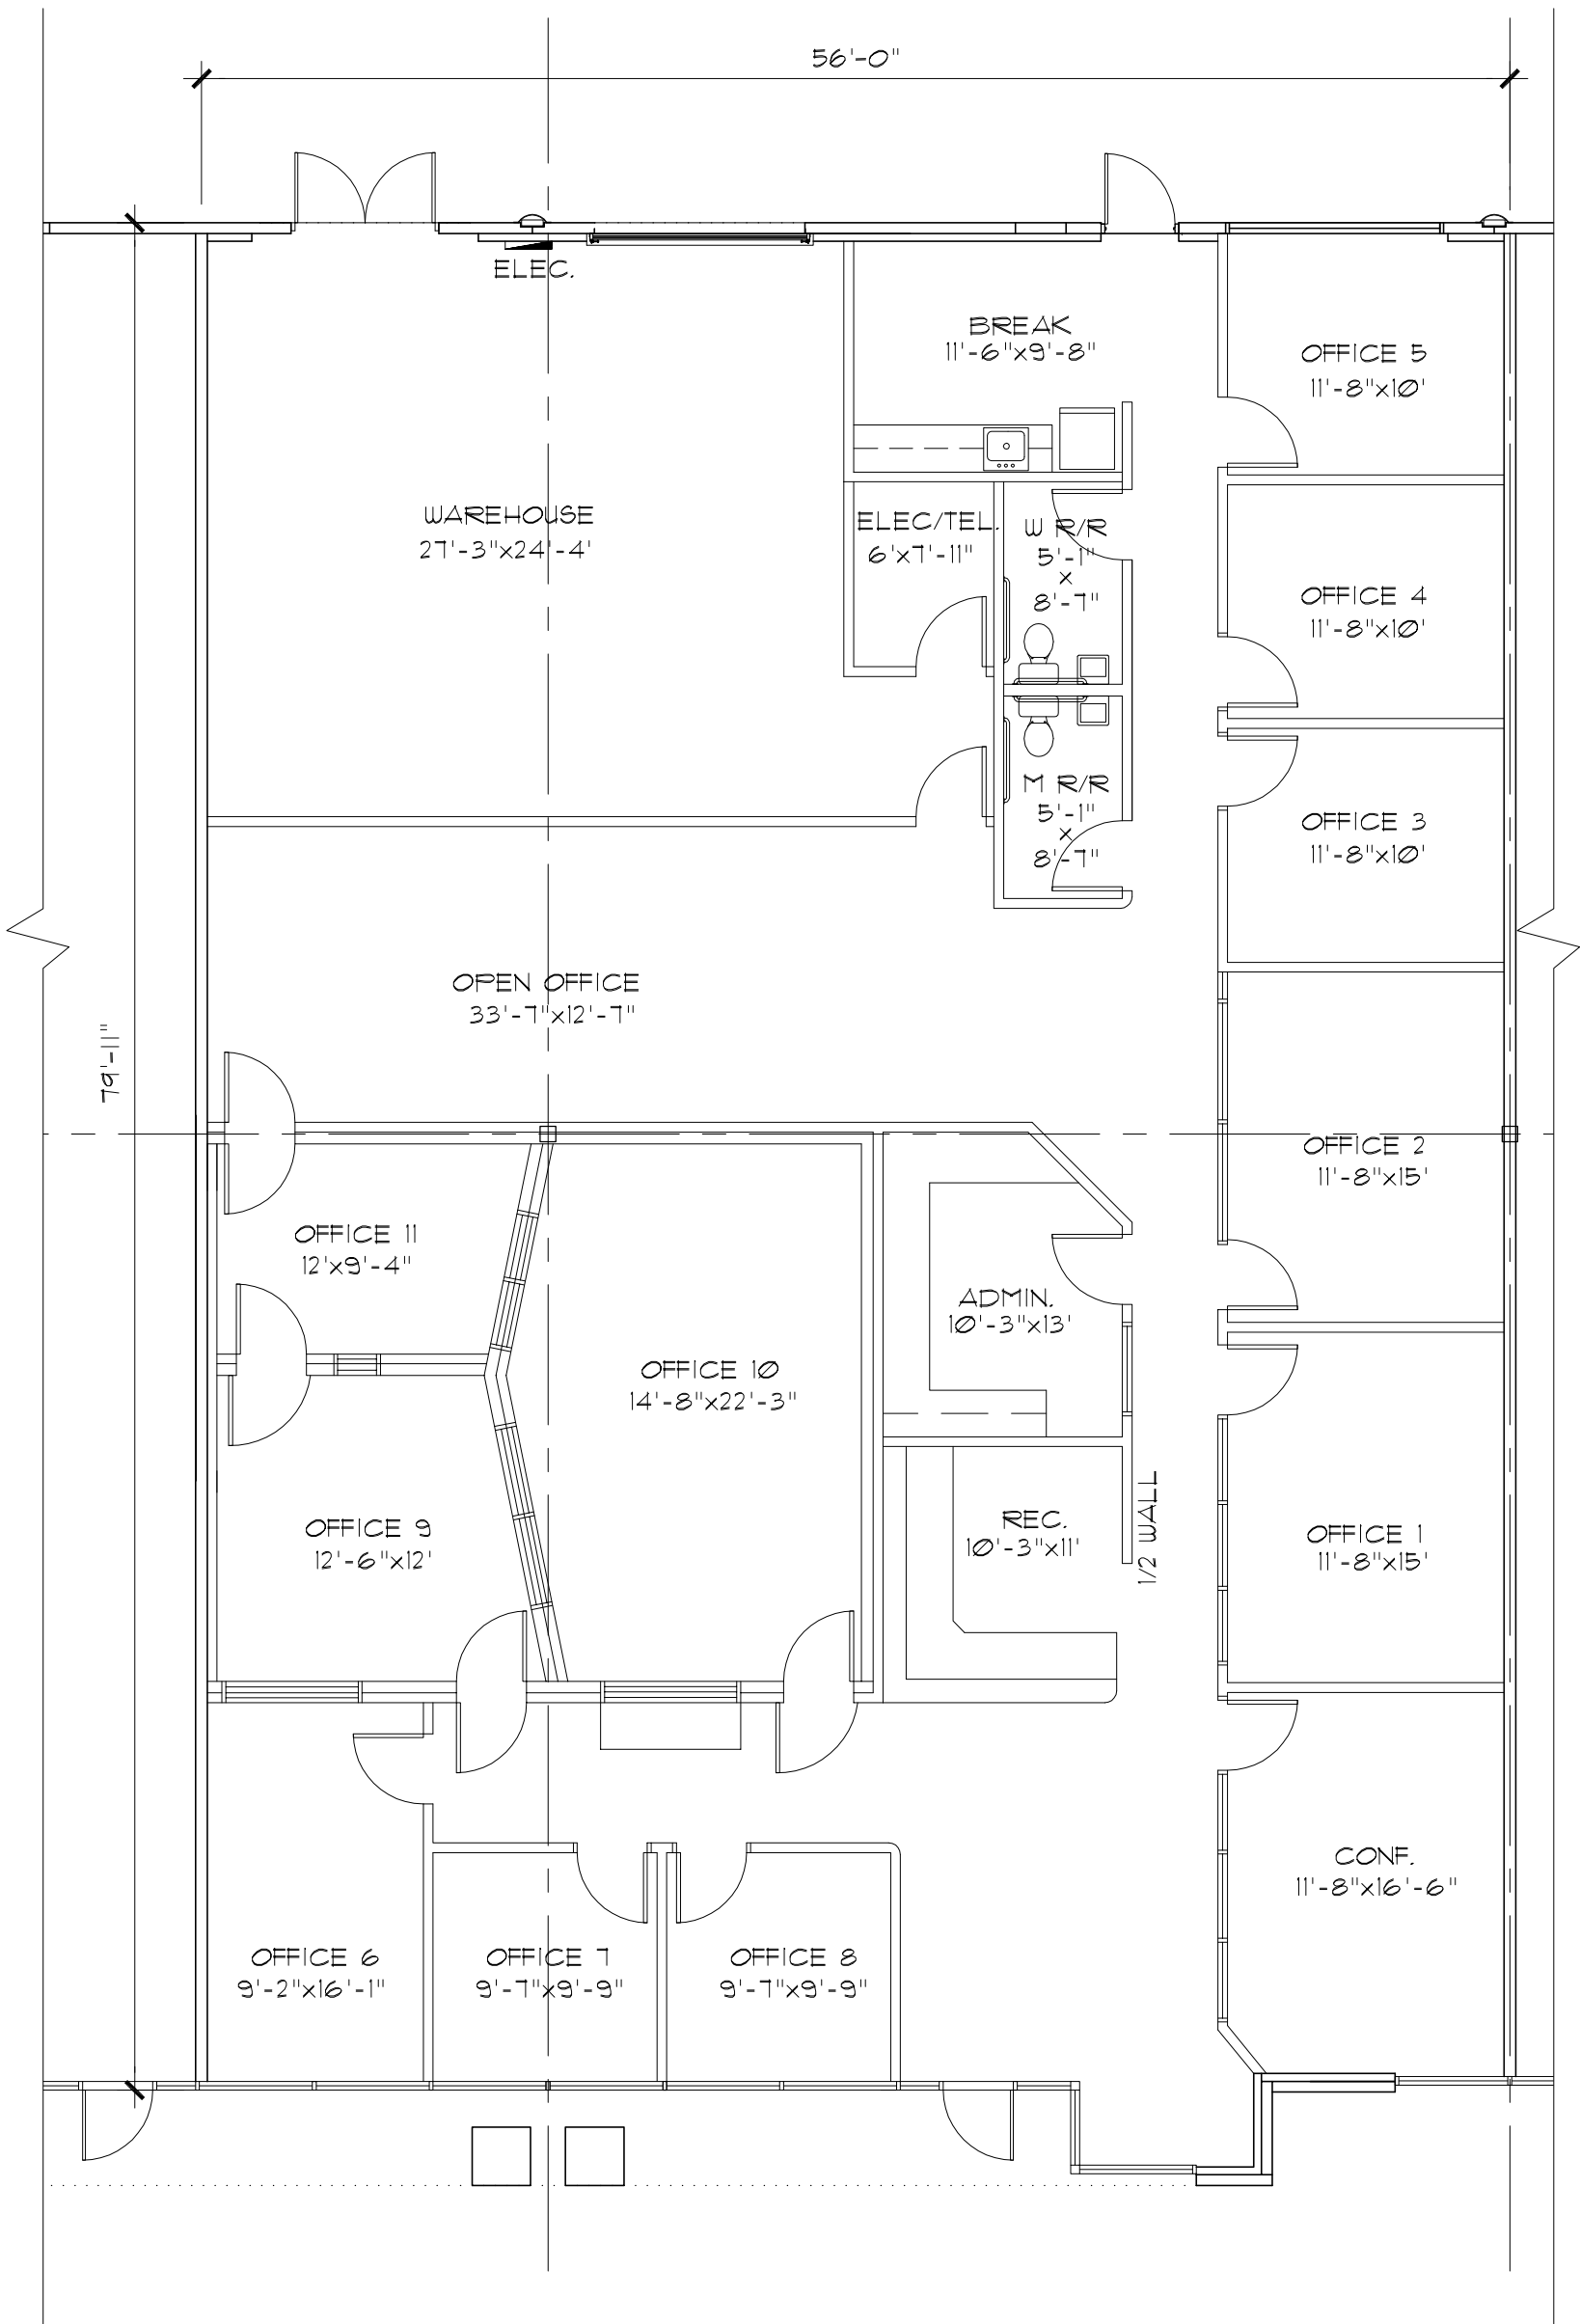

01 **AS-BUILT FLOOR PLAN**

SCALE: 1/8"=1'-0"

ALL DIMENSIONS ARE APPROXIMATE AND ALL INFORMATION IS OF GENERAL NATURE



LEASE AREA:

OFFICE:	3,926 S.F.
WAREHOUSE:	751 S.F.
TOTAL:	4,677 S.F.

AB1

DRAWN	NPS
CHECKED	MDN
DATE	04/19/16
PROJECT	
JOB NO.	16-095
SHEET	

AS-BUILT FLOOR PLAN

1218 ARION PKWY, STE. 106
SAN ANTONIO, TX 78216



VILLA PARK

ARCHITECTURE/PLANNING/INTERIORS PLLC
300 W. BITTERS ROAD, SUITE 204 VOICE: (210) 384-8900
SAN ANTONIO, TX. 78216 FAX: (210) 384-8240

© 2015 ALL RIGHTS RESERVED