


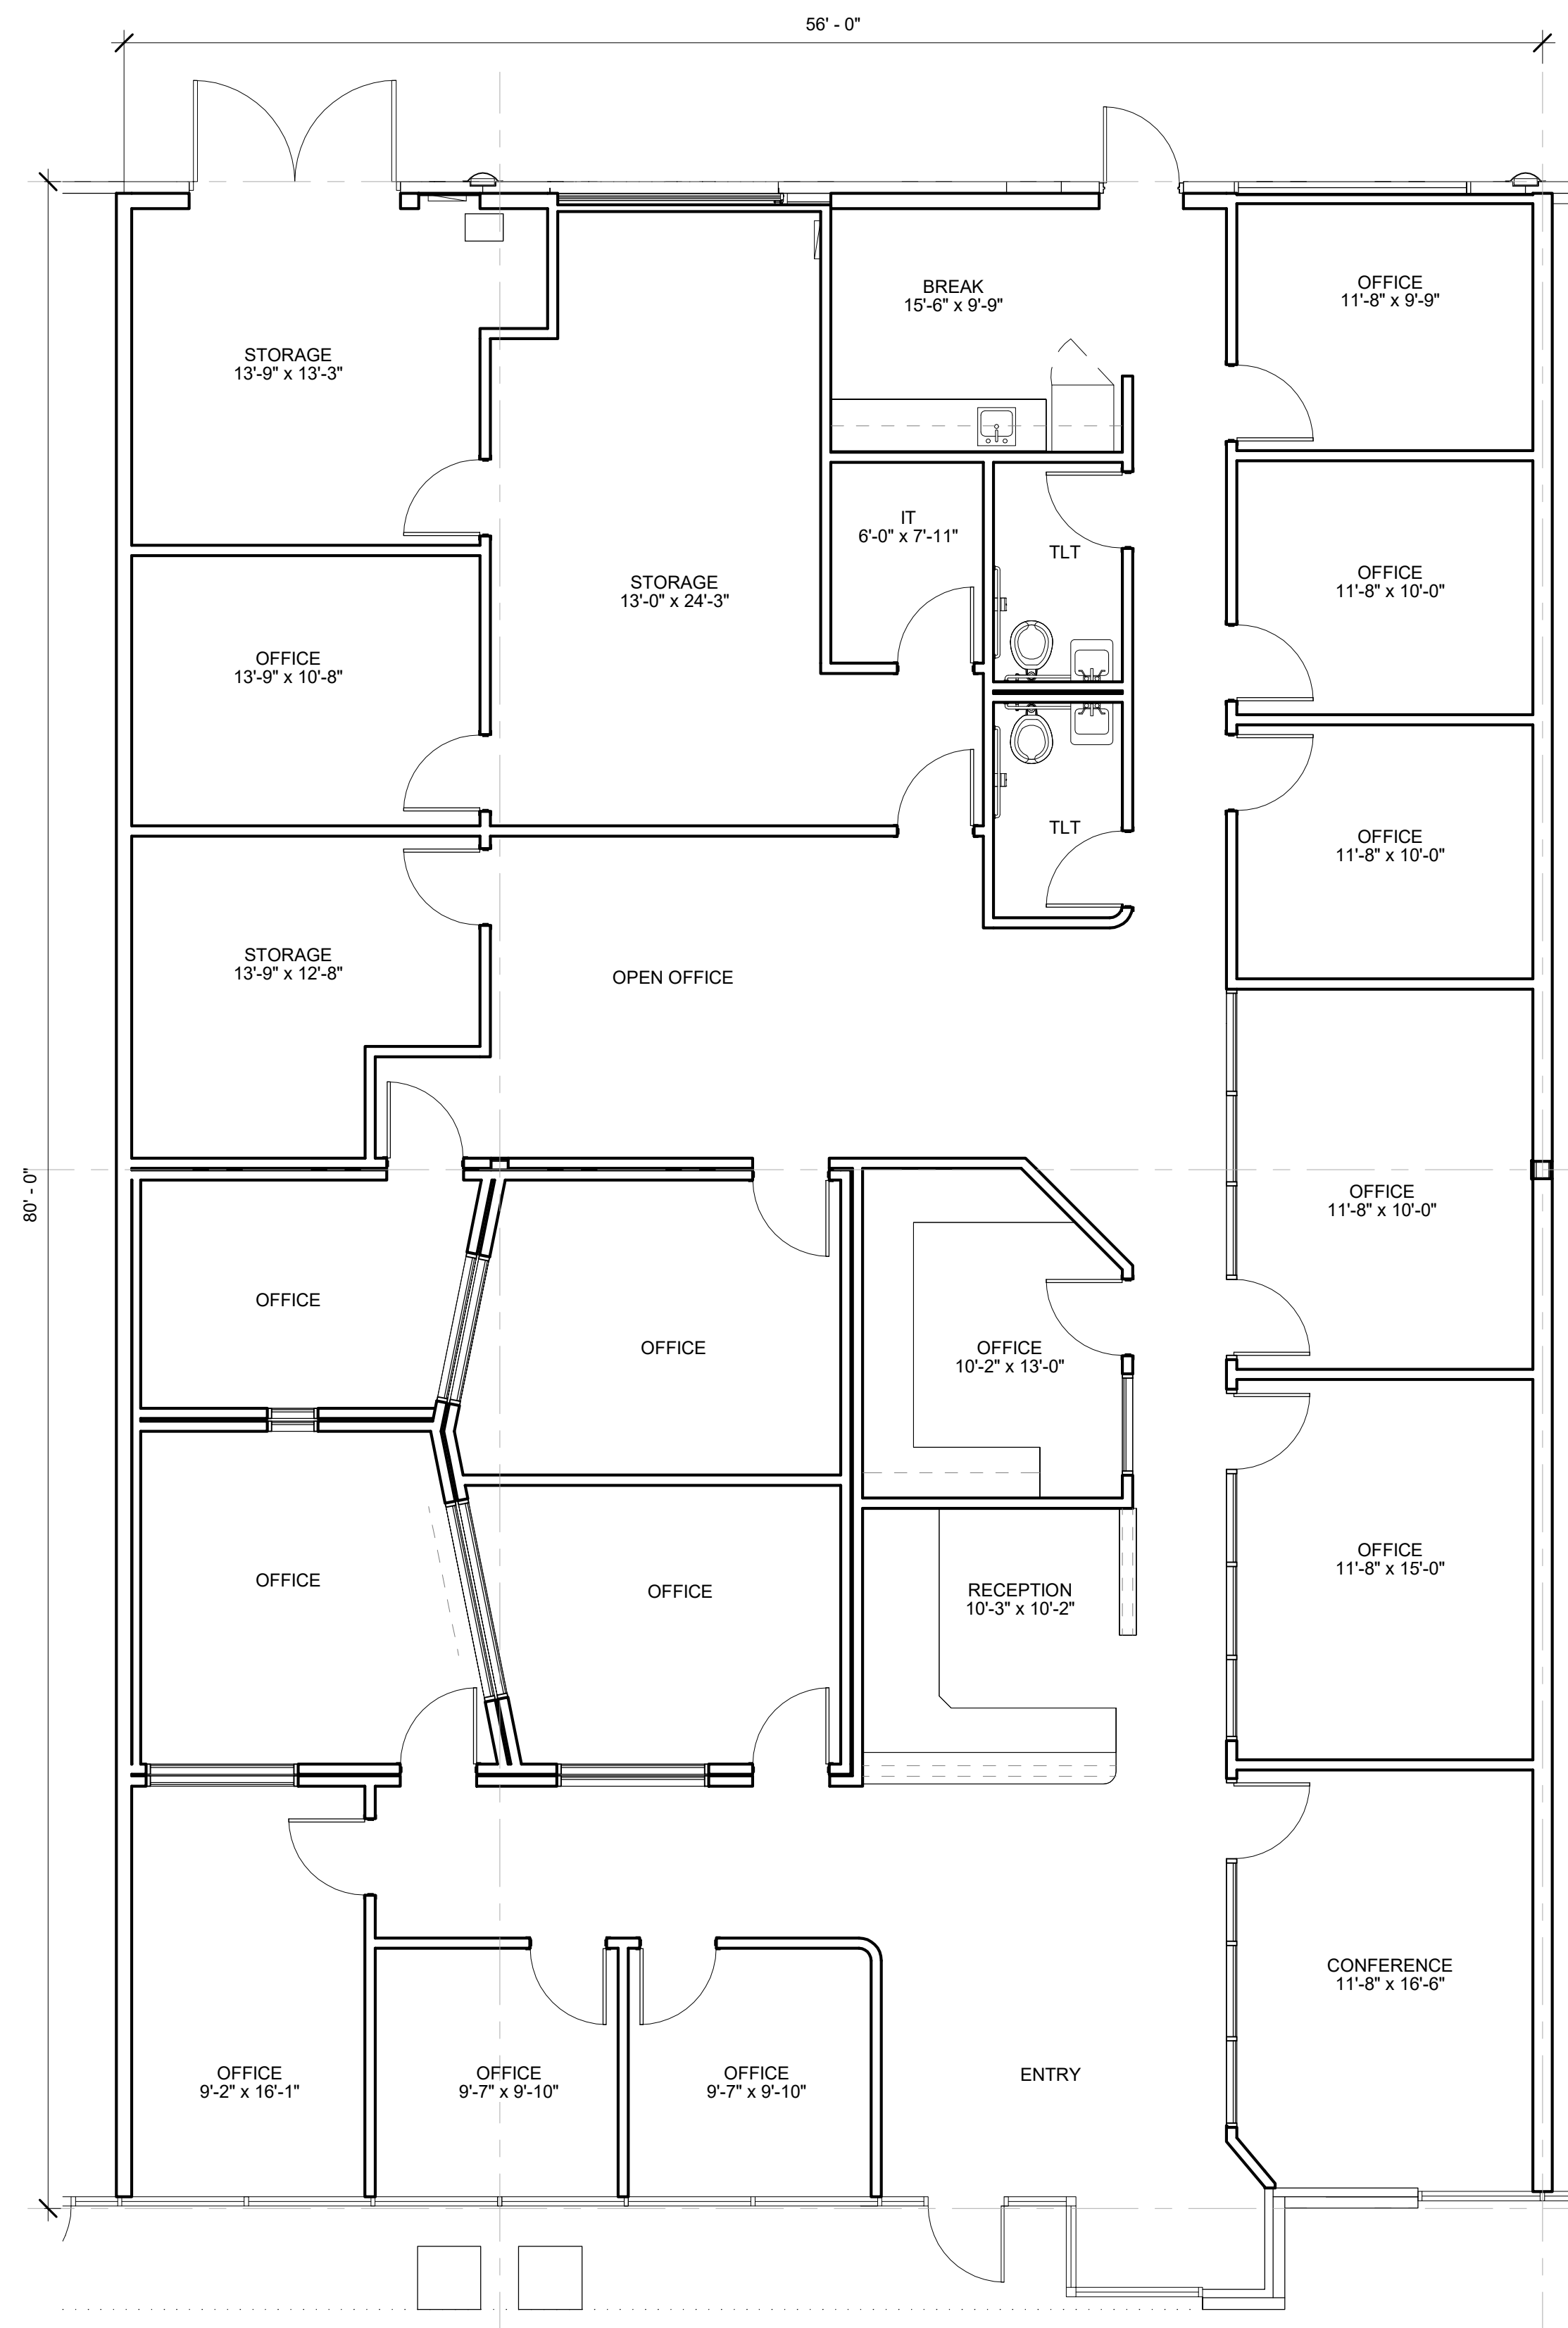

Arion 17, Suite 106 - As-Built Plan

1218 Arion Pkwy, Suite 106, San Antonio, TX 78216

Scale: 3/16" = 1'-0"

① As-Built Plan
3/16" = 1'-0"

Area: +/-4,677 SF
09/16/25

LKDG Prj. No: 25268

LK design group

architecture . planning . interiors
16010 Via Shavano - San Antonio, Texas 78249
210.824.8825 fax 210.824.4150