


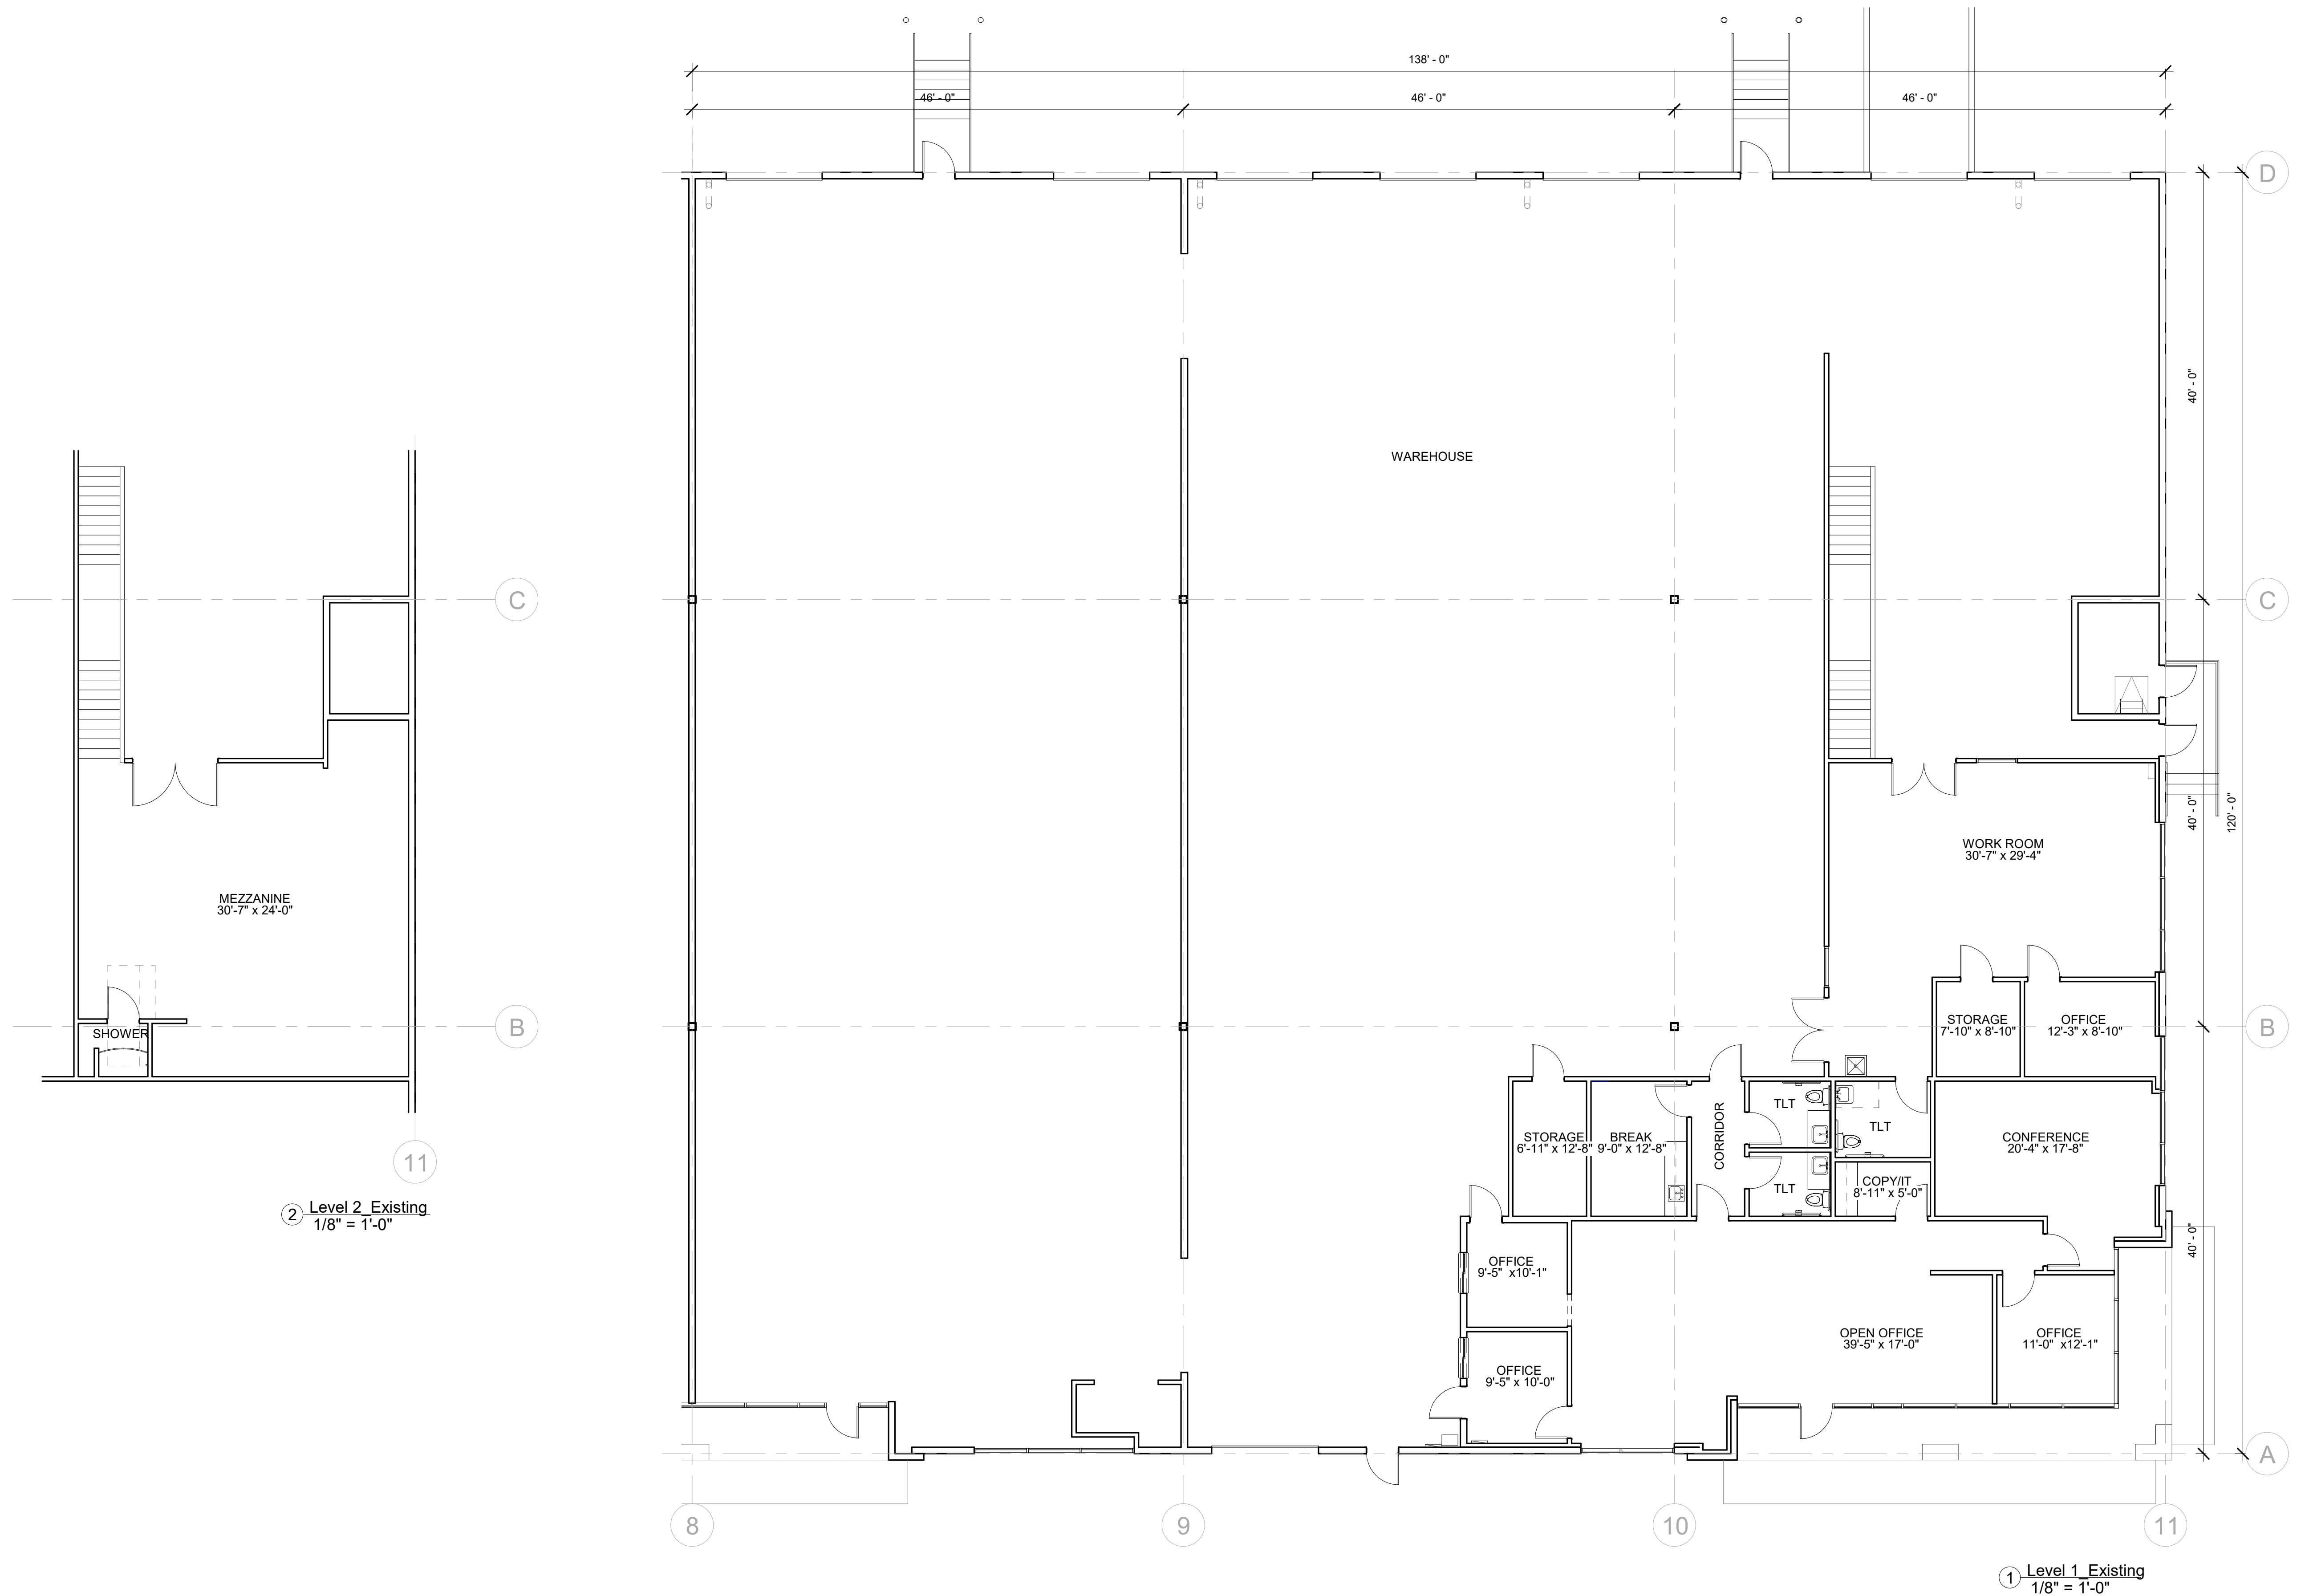

12625 Wetmore, Suite 202 - As-Built Floor Plan

12625 Wetmore, Ste. 202, San Antonio, TX 78247

AREA:
OFFICE: 3,211 SF
WAREHOUSE: 13,407 SF
FIRST FLOOR TOTAL: 16,618 SF

MEZZANINE: 981 SF

08/15/25

LKDG Prj. No25231



Scale: 1/8" = 1'-0"