


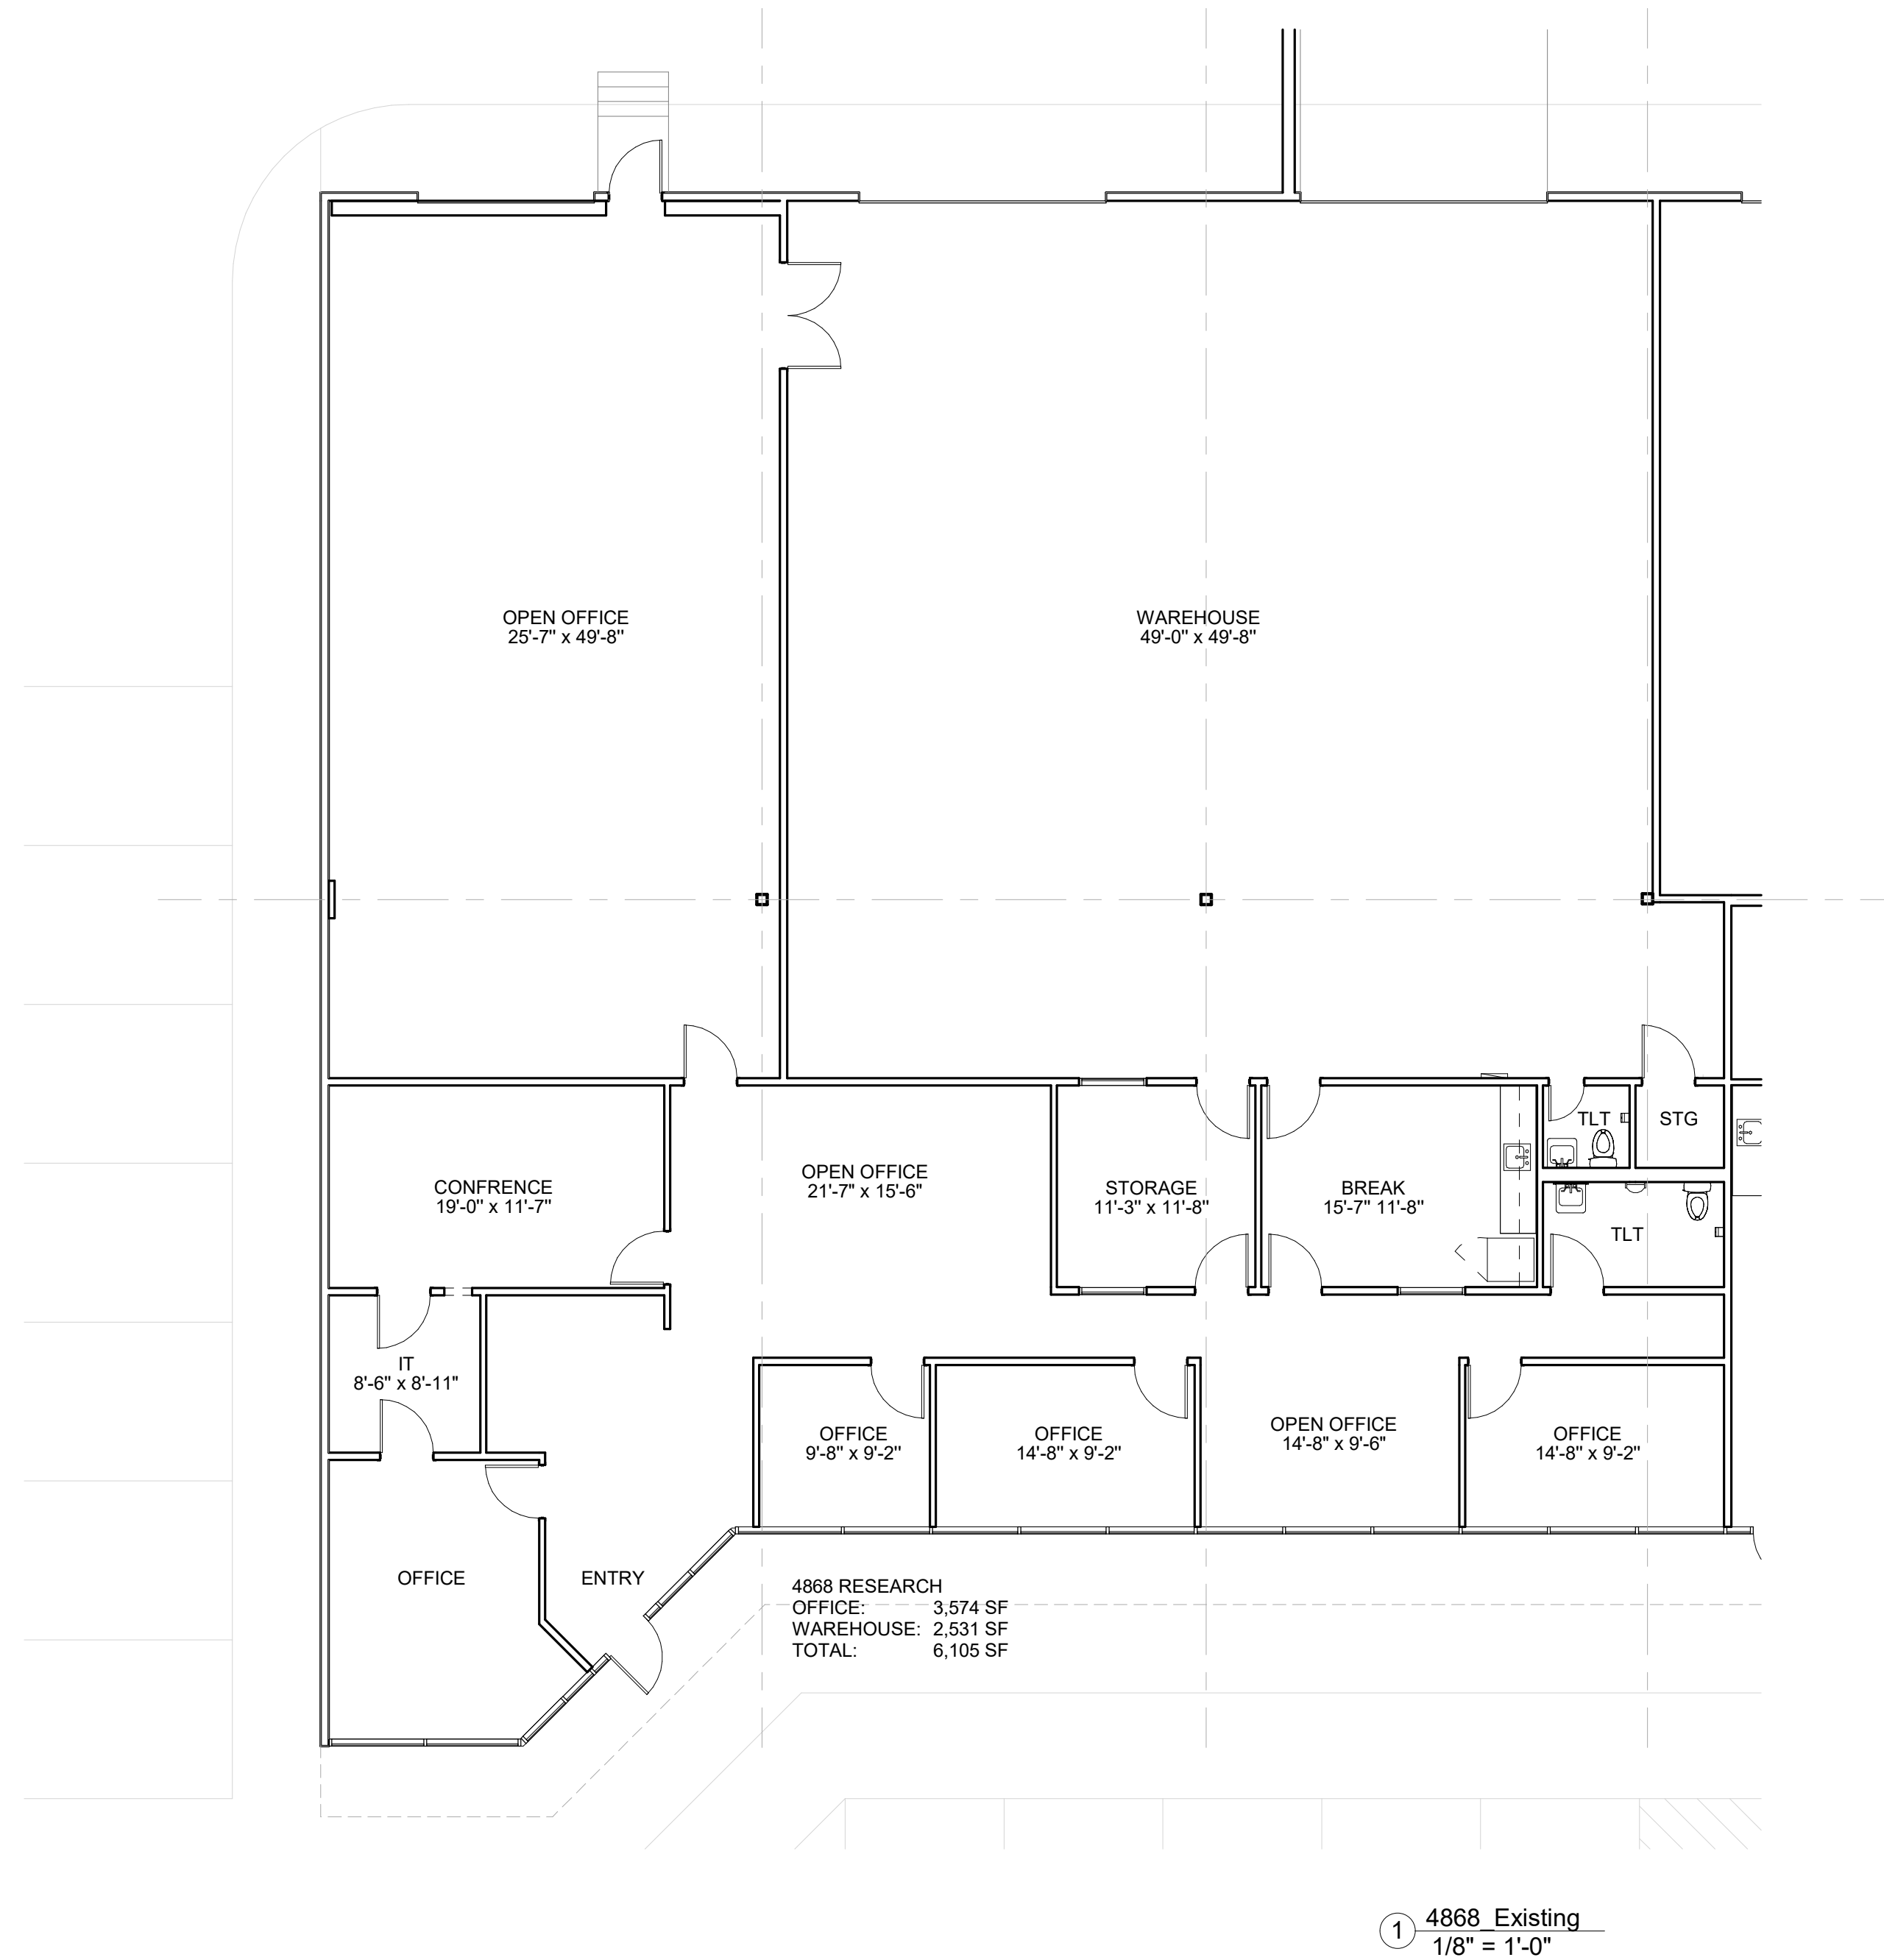

Bldg 5-Northwest Corporate Center - As-Built Floor Plan

Research Drive, San Antonio, Tx.

Scale: 1/8" = 1'-0"


4868 RESEARCH
Area: 6,105 SF
10/22/2025

LKDG Prj. No: 24120




architecture . planning . interiors

16010 Via Shavano - San Antonio, Texas 78249
210.824.8825 fax 210.824.4150

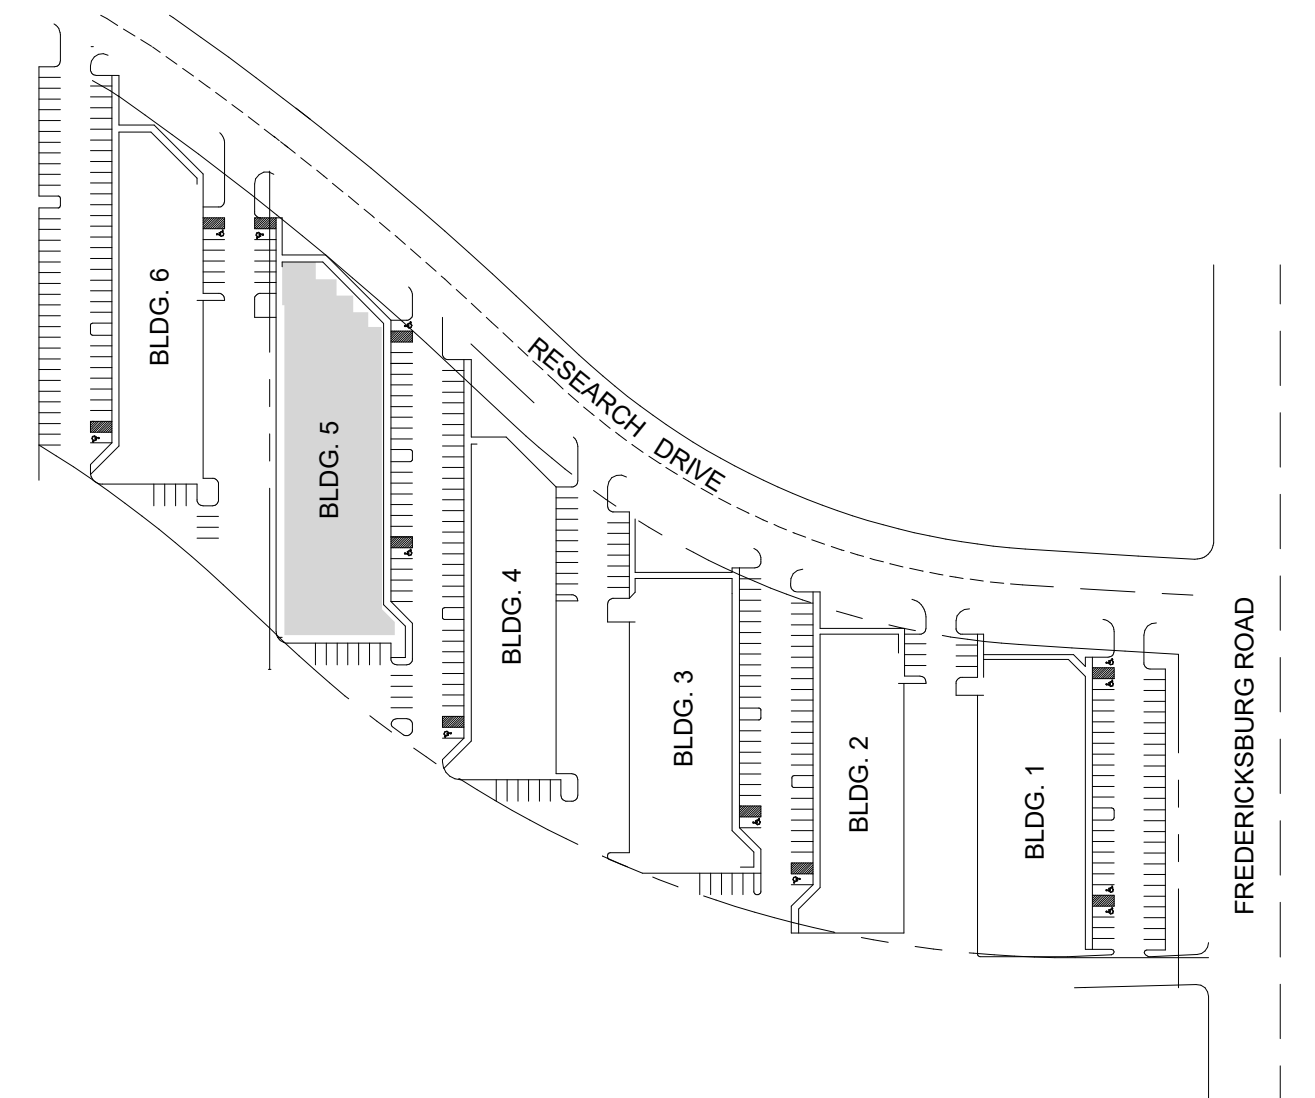

② KEY PLAN
1" = 160'-0"

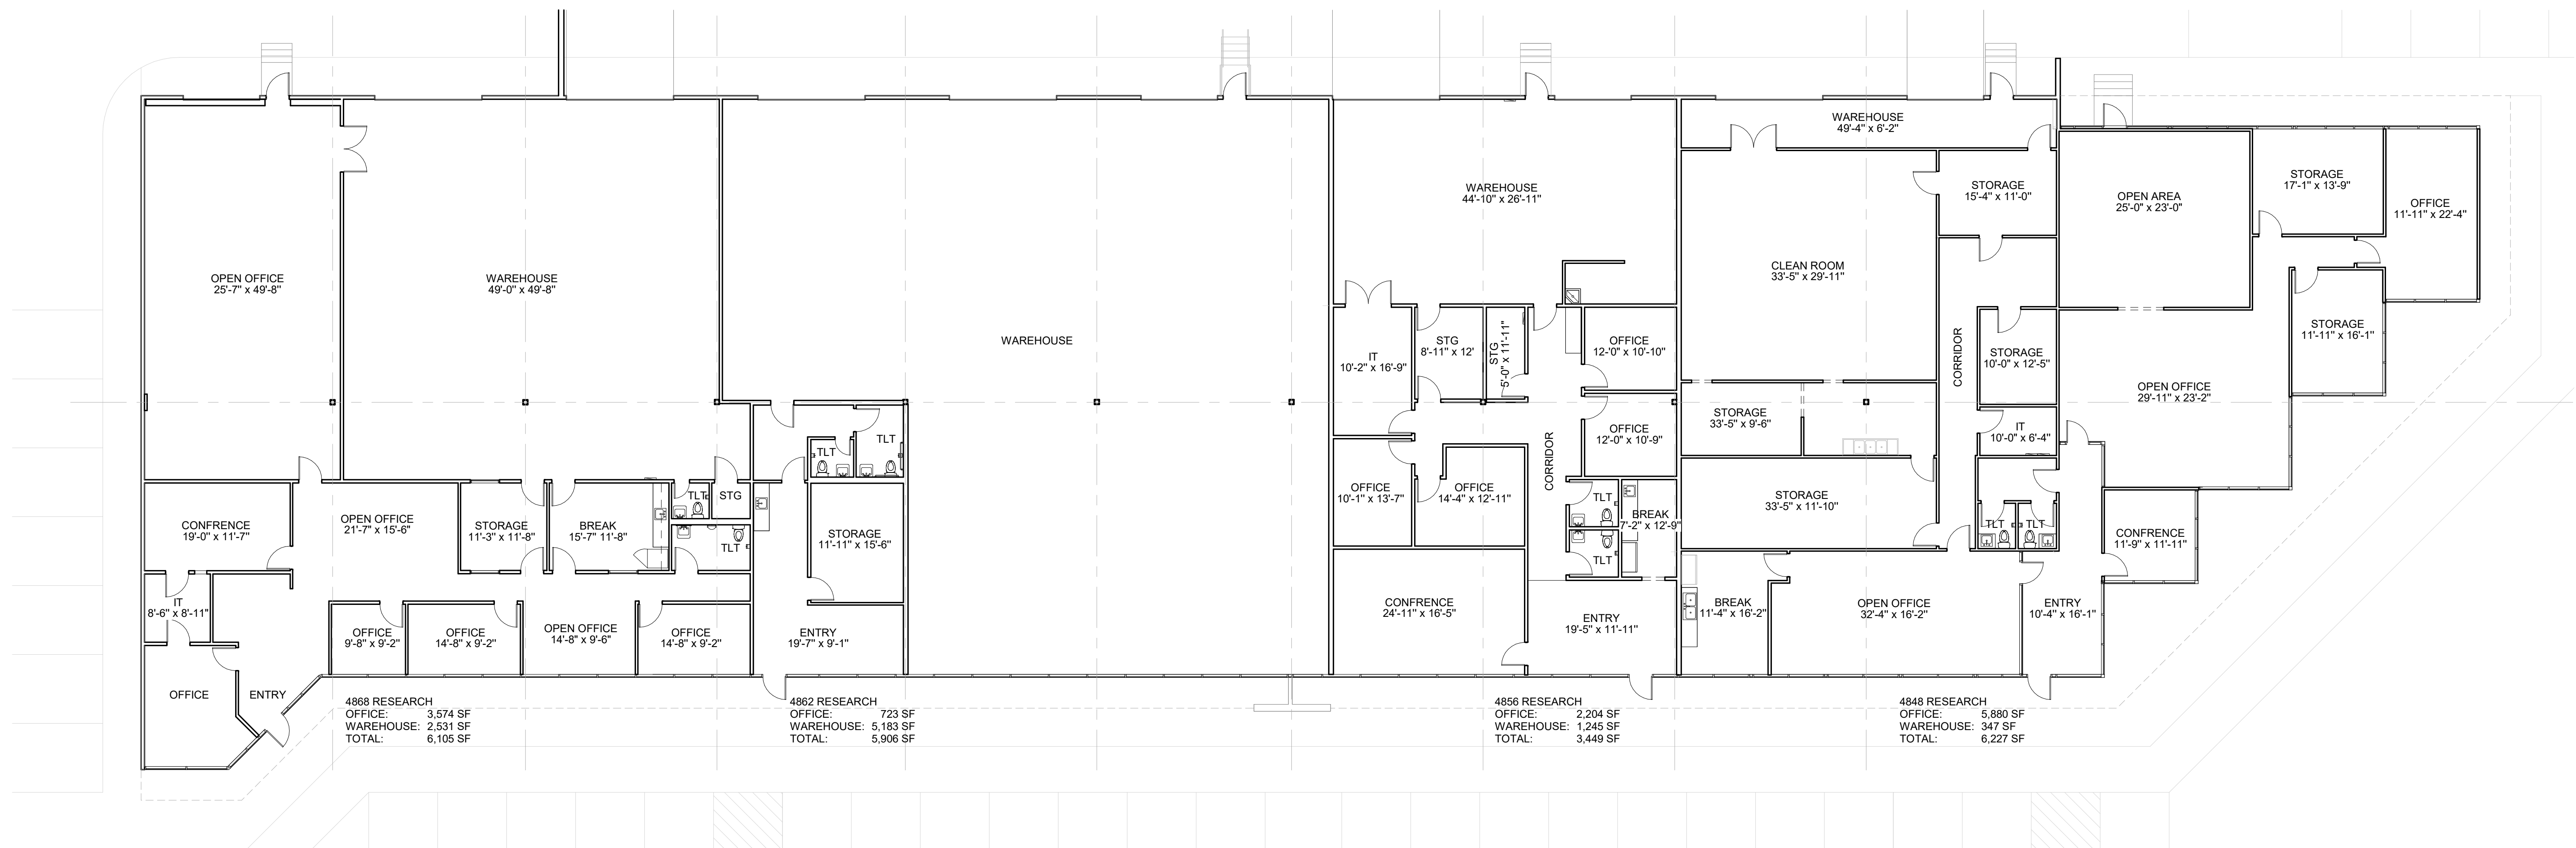

① Level 5 Existing
3/32" = 1'-0"

Bldg 5-Northwest Corporate Center - As-Built Floor Plan

Research Drive, San Antonio, Tx.

Scale: As indicated

Area: TOTAL AREA: 21,687 SF

10/22/2025

LKDG Prj. No: 24120

LK design group

architecture . planning . interiors

16010 Via Shavano - San Antonio, Texas 78249
210.824.8825 fax 210.824.4150