


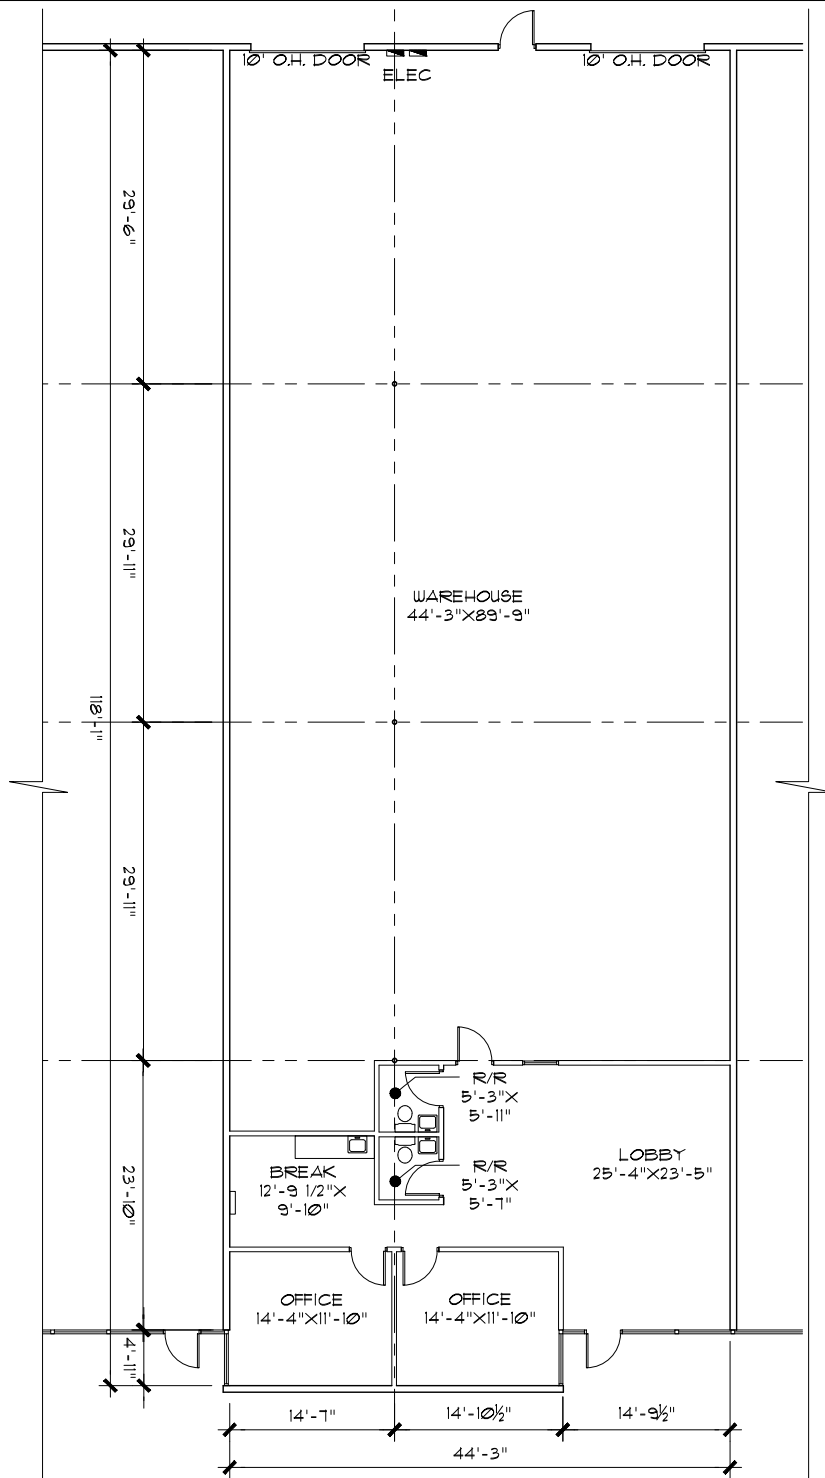

AS-BUILT FLOOR PLAN-5,400 SF.

SCALE: GRAPHIC



NOTE:

ALL DIMENSIONS ARE APPROXIMATE AND ALL INFORMATION IS OF GENERAL NATURE

AB1-102218

AB1

DRAWN
CHECKED
DATE
10/22/18
PROJECT
3015 INTERSTATE DR
108 302
SHEET

AS BUILT FLOOR PLAN

3015 INTERSTATE DR
SAN ANTONIO, TEXAS

