


These drawings are to be an instrument of service and shall remain the property of the Architect. They are not to be used on other projects or extensions to this project except by agreement in writing and with appropriate compensation to the Architect. Contractor is responsible for confirming and correlating dimensions at the job site; the Architect will not be responsible for construction means, methods, techniques, sequences or procedures, or for safety precautions and programs in connection with the project.

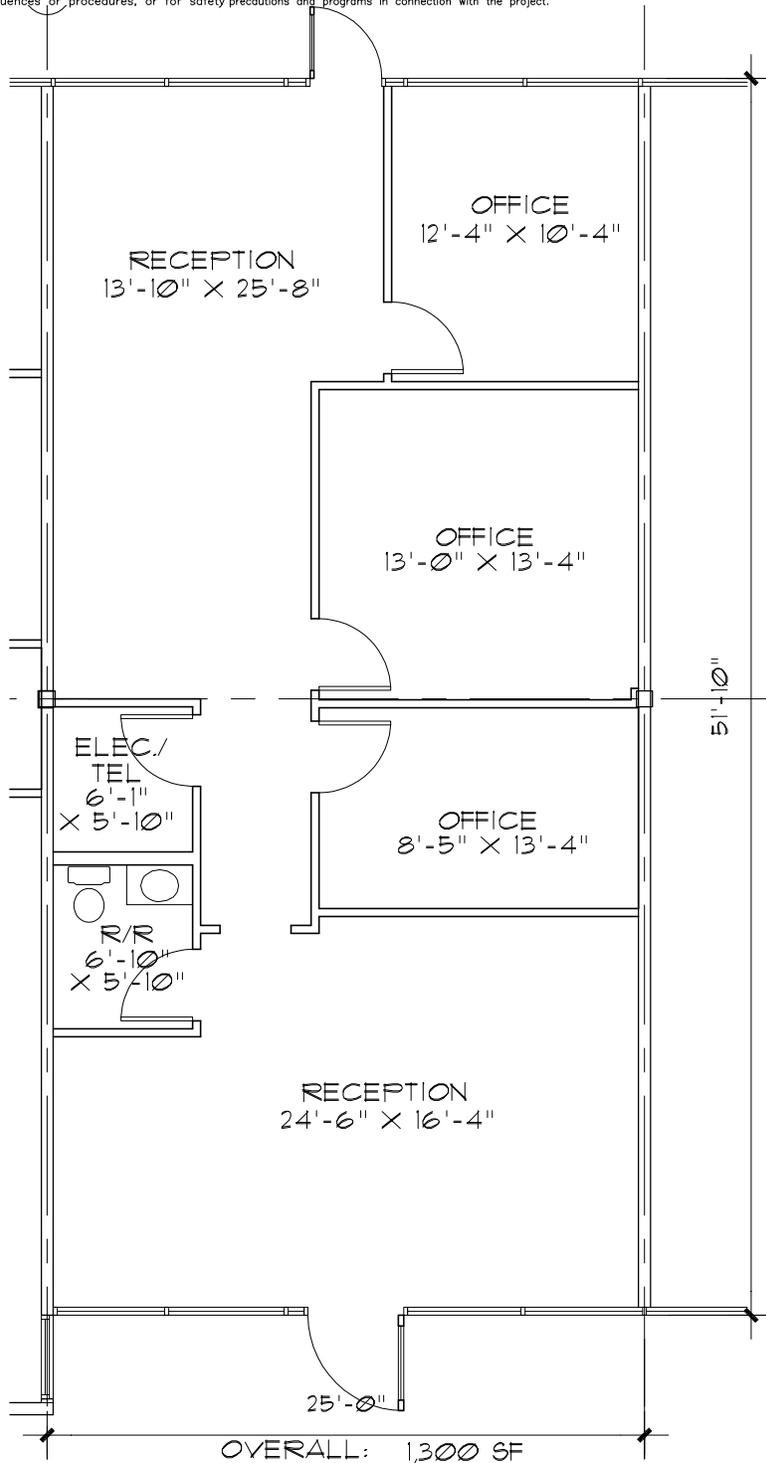

AS-BUILT FLOOR PLAN

SCALE: 1/8"=1'-0"

AS1

SHEET

DATE	08/07/15
CHECKED	MDN
DRAWN	AEV
PROJECT	4936 RESEARCH
JOB. NO.	10-018

ARCHITECTURAL SURVEY

4936 RESEARCH DRIVE
SAN ANTONIO, TEXAS



VILLA PARK
ARCHITECTURE/PLANNING/INTERIORS

300 W. BITTERS RD. SUITE 204
SAN ANTONIO, TX. 78216
VOICE: (210) 384-8900
FAX: (210) 384-8240

© 2015 ALL RIGHTS RESERVED