


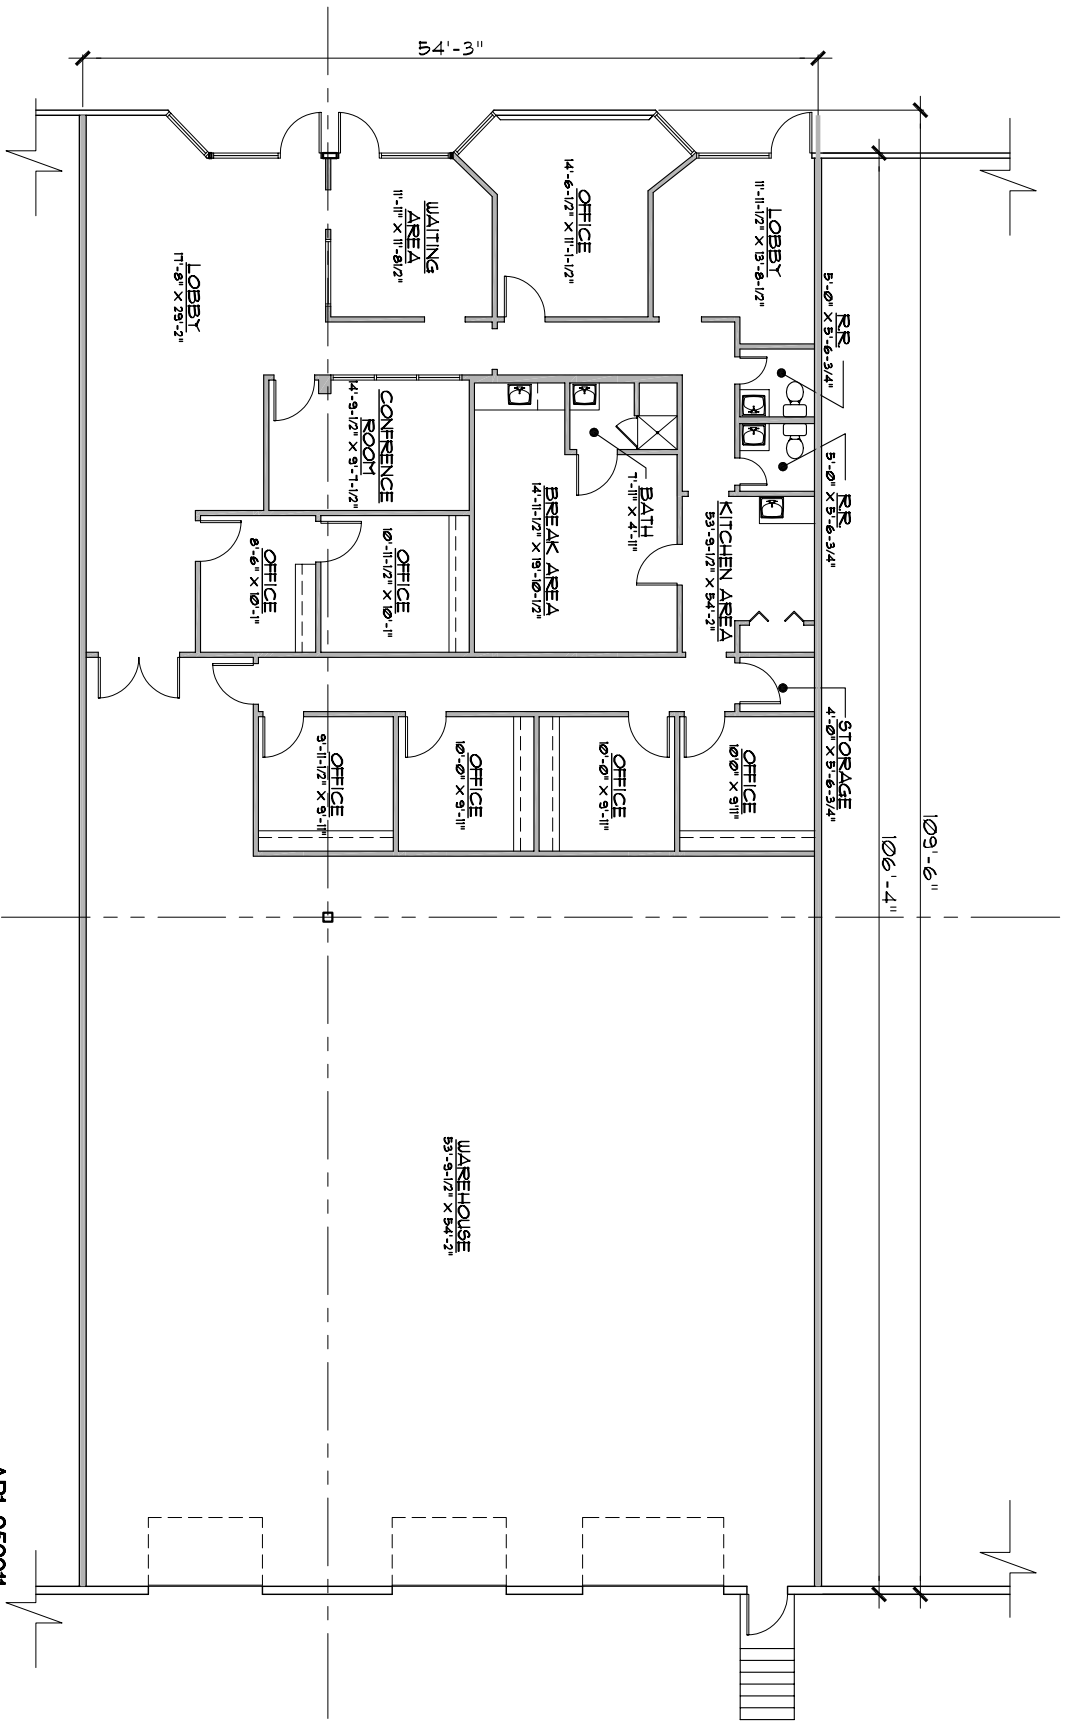

AS-BUILT FLOOR PLAN



NORTH


SCALE: GRAPHIC



OFFICE:	2,788 S.F.
WAREHOUSE:	3,152 S.F.
TOTAL:	5,940 S.F.

NOTE: ALL DIMENSIONS ARE APPROXIMATE AND ALL INFORMATION IS OF GENERAL NATURE

VICINITY MAP

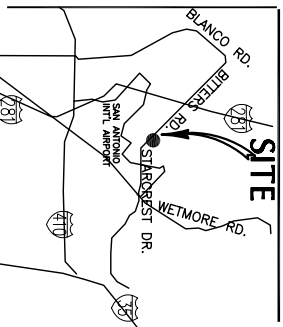

ABI-050911

AS-BUILT FLOOR PLAN

12081 STARCREST
BLOSSOM BUSINESS PARK
SAN ANTONIO, TEXAS





VILLA PARK

ARCHITECTURE/PLANNING/INTERIORS, PLLC

2553 JACKSON KELLER, SUITE 1
SAN ANTONIO, TX. 78230

VOICE: (210) 384-8900
FAX: (210) 384-8240

© 2011 ALL RIGHTS RESERVED

ABI

DRAWN	RR
CHECKED	MDN
DATE	050911
PROJECT	12081 Starcrest
JOB. NO.	11-083
SHEET	