These drawings are to be an instrument of service and shall remain the property of the Architect. They are not to be used on other projects or extensions to this project except by agreement in writing and with appropriate compensation to the Architect. Contractor is responsible for confirming and correlating dimensions at the job site; the Architect will not be responsible for construction means, methods, techniques, sequences or procedures, or for safety precautions and programs in connection with the project.

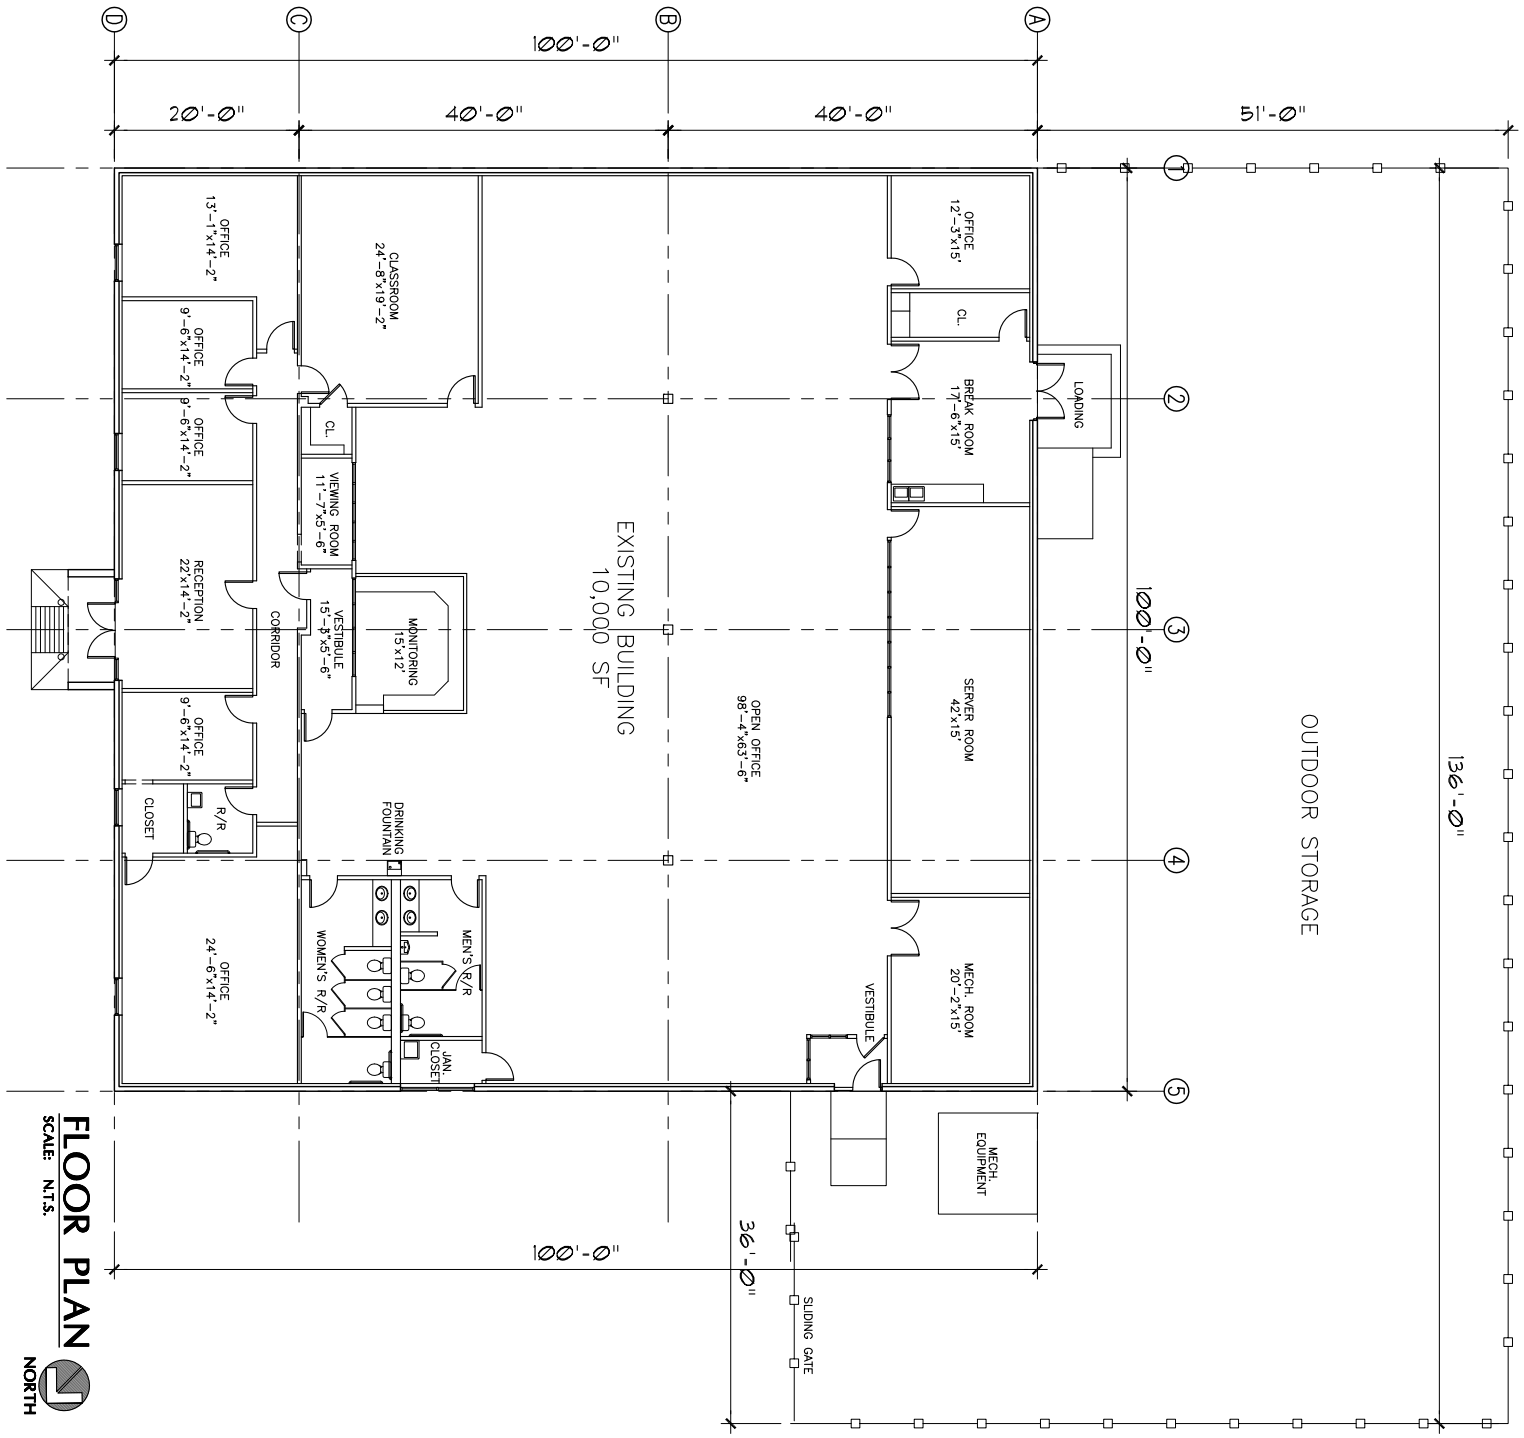

FLOOR PLAN
SCALE: N.T.S.

NORTH

NOTE:
THIS CONCEPTUAL PLAN IS FOR MARKETING PURPOSES ONLY, AND HAS BEEN PREPARED FOR CLIENT BASED UPON PRELIMINARY AVAILABLE SITE AND BUILDING INFORMATION DEEMED RELIABLE. ALL DIMENSIONS, GRADES, AND AREA CALCULATIONS ARE SUBJECT TO VERIFICATION AND MODIFICATION BY A PROFESSIONAL FOR COMPLIANCE WITH ALL NATIONAL, STATE, AND LOCAL REGULATIONS. NOT FOR REGULATORY APPROVAL, PERMITTING, OR CONSTRUCTION.

SHEET A1.1

DRAWN AEV
CHECKED MDM
DATE 032309
PROJECT EXISITING FP
JOB. NO. 09-050
REVISIONS

EXISTING FLOOR PLAN

2438 Boardwalk
San Antonio, Texas

PROGRESS REVIEW
NOT FOR REGULATORY APPROVAL, PERMITTING, OR CONSTRUCTION

VILLA PARK
ARCHITECTURE/PLANNING/INTERIORS
2553 JACKSON KELLER, SUITE 1
SAN ANTONIO, TX. 78230
VOICE: (210) 384-8900
FAX: (210) 384-8240

© 2009 ALL RIGHTS RESERVED