These drawings are to be an instrument of service and shall remain the property of the Architect. They are not to be used on other projects or extensions to this project except by agreement in writing and with appropriate compensation to the Architect. Contractor is responsible for confirming and correlating dimensions at the job site; the Architect will not be responsible for construction means, methods, techniques, sequences or procedures, or for safety precautions and programs in connection with the project.

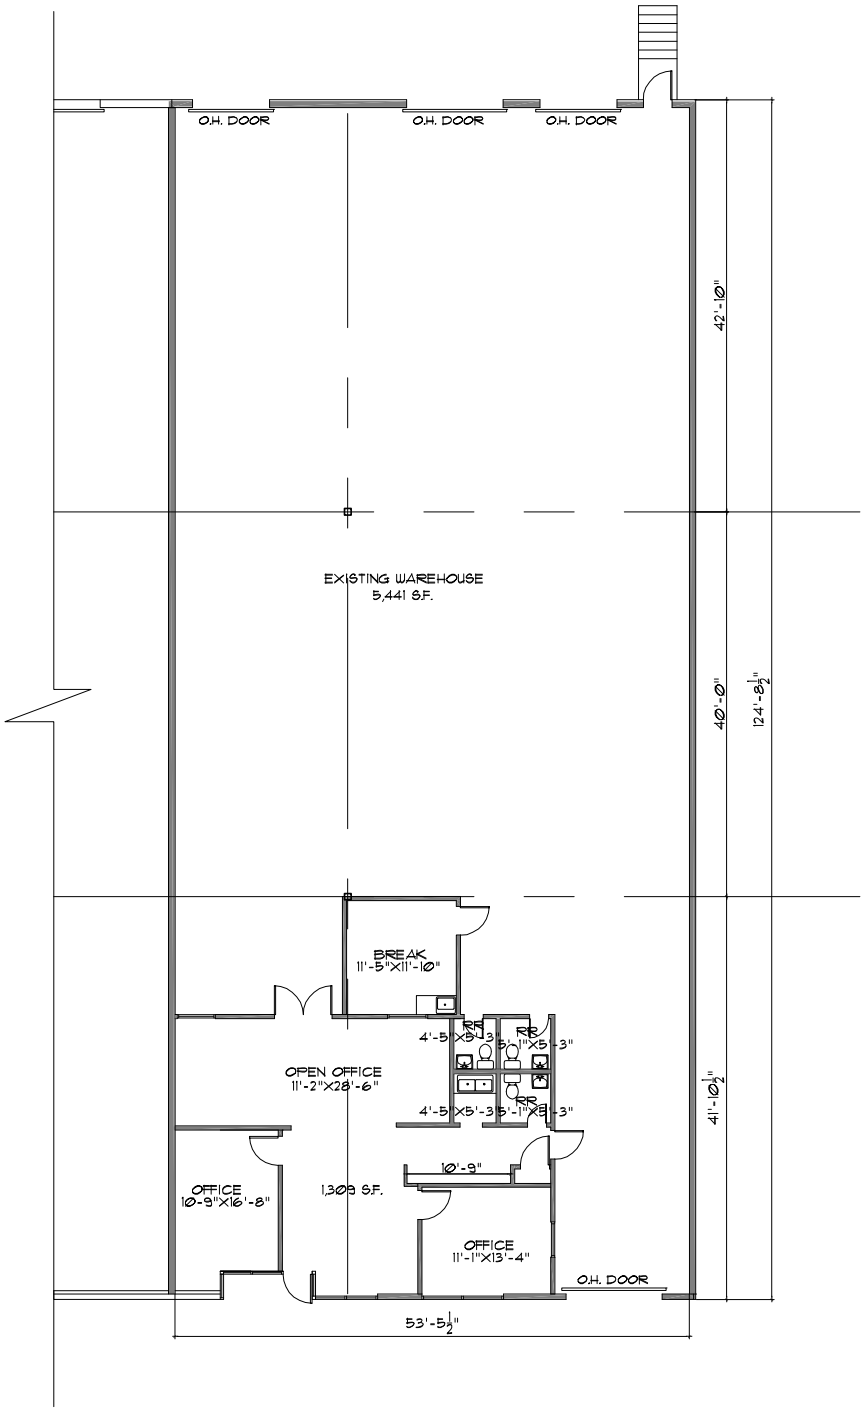

FLOOR PLAN

SCALE: N.T.S.

OFFICE: 1, 309 S.F.
WAREHOUSE: 5, 441 S.F.
TOTAL: 6, 750 S.F.

SK1

SHEET
08-047
JOB: NO:
AS-BUILTS
PROJECT
121008
DATE
MDN
CHECKED
AEV
DRAWN

ARCHITECTURAL SURVEY

10560 SENTINEL
SAN ANTONIO, TEXAS

NOT FOR REGULATORY APPROVAL, PERMITTING, OR CONSTRUCTION

REGISTERED ARCHITECT
MARK DOUGLAS NOVILLE
16076
STATE OF TEXAS

VILLA PARK
ARCHITECTURE/PLANNING/INTERIORS
2553 JACKSON KELLER, SUITE 1 VOICE: (210) 384-8900
SAN ANTONIO, TX. 78230 FAX: (210) 384-8240

© 2008 ALL RIGHTS RESERVED