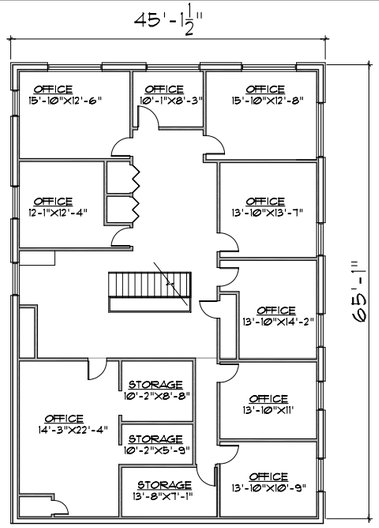

SECOND-FLOOR

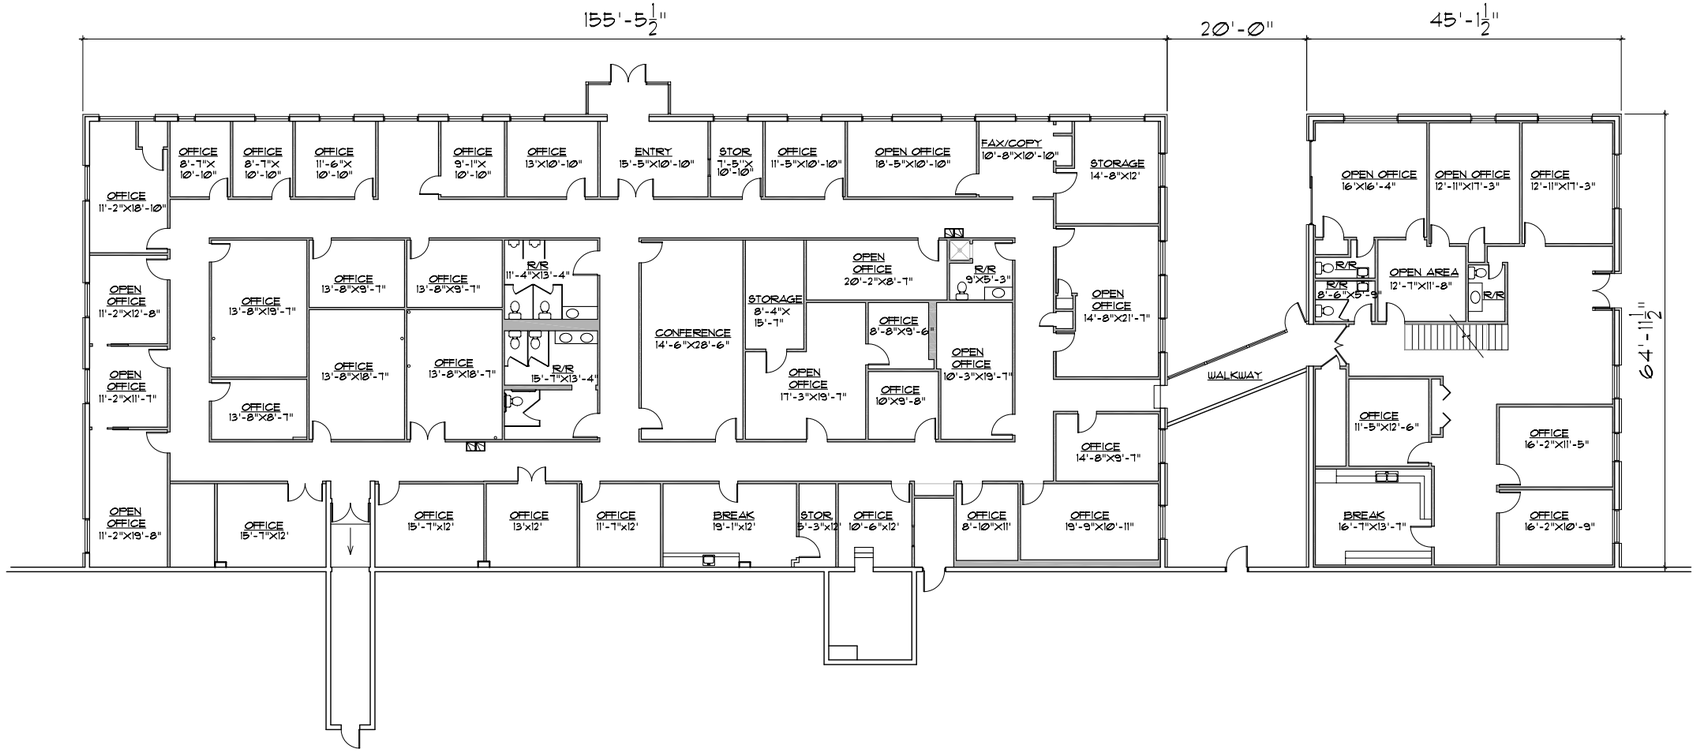

FIRST-FLOOR
AS-BUILT FLOOR PLANS

SCALE: GRAPHIC

NOTE: ALL DIMENSIONS ARE APPROXIMATE AND ALL INFORMATION IS OF GENERAL NATURE

PLAN NORTH

0' 25' 50' 100'

THIS CONCEPTUAL SITE PLAN IS FOR MARKETING PURPOSES ONLY, AND HAS BEEN PREPARED FOR CLIENT BASED UPON PRELIMINARY AVAILABLE SITE INFORMATION DEEMED RELIABLE. ALL DIMENSIONS, GRADES AND AREA CALCULATIONS ARE SUBJECT TO VERIFICATION AND MODIFICATION BY A PROFESSIONAL CIVIL ENGINEER FOR COMPLIANCE WITH ALL NATIONAL, STATE, AND LOCAL REGULATIONS. NOT FOR REGULATORY APPROVAL, PERMITTING, OR CONSTRUCTION.

AB1-011012

VILLA PARK
ARCHITECTURE/PLANNING/INTERIORS, PLLC
PH. (210) 384-8900
© 2011 ALL RIGHTS RESERVED

AS BUILT FLOOR PLAN

4430 DIRECTOR
San Antonio, Texas

DRAWN
MAR
CHECKED
MDN
DATE
01/10/12
PROJECT
4430 DIRECTOR
JOB NO.
11-256
SHEET
AB1