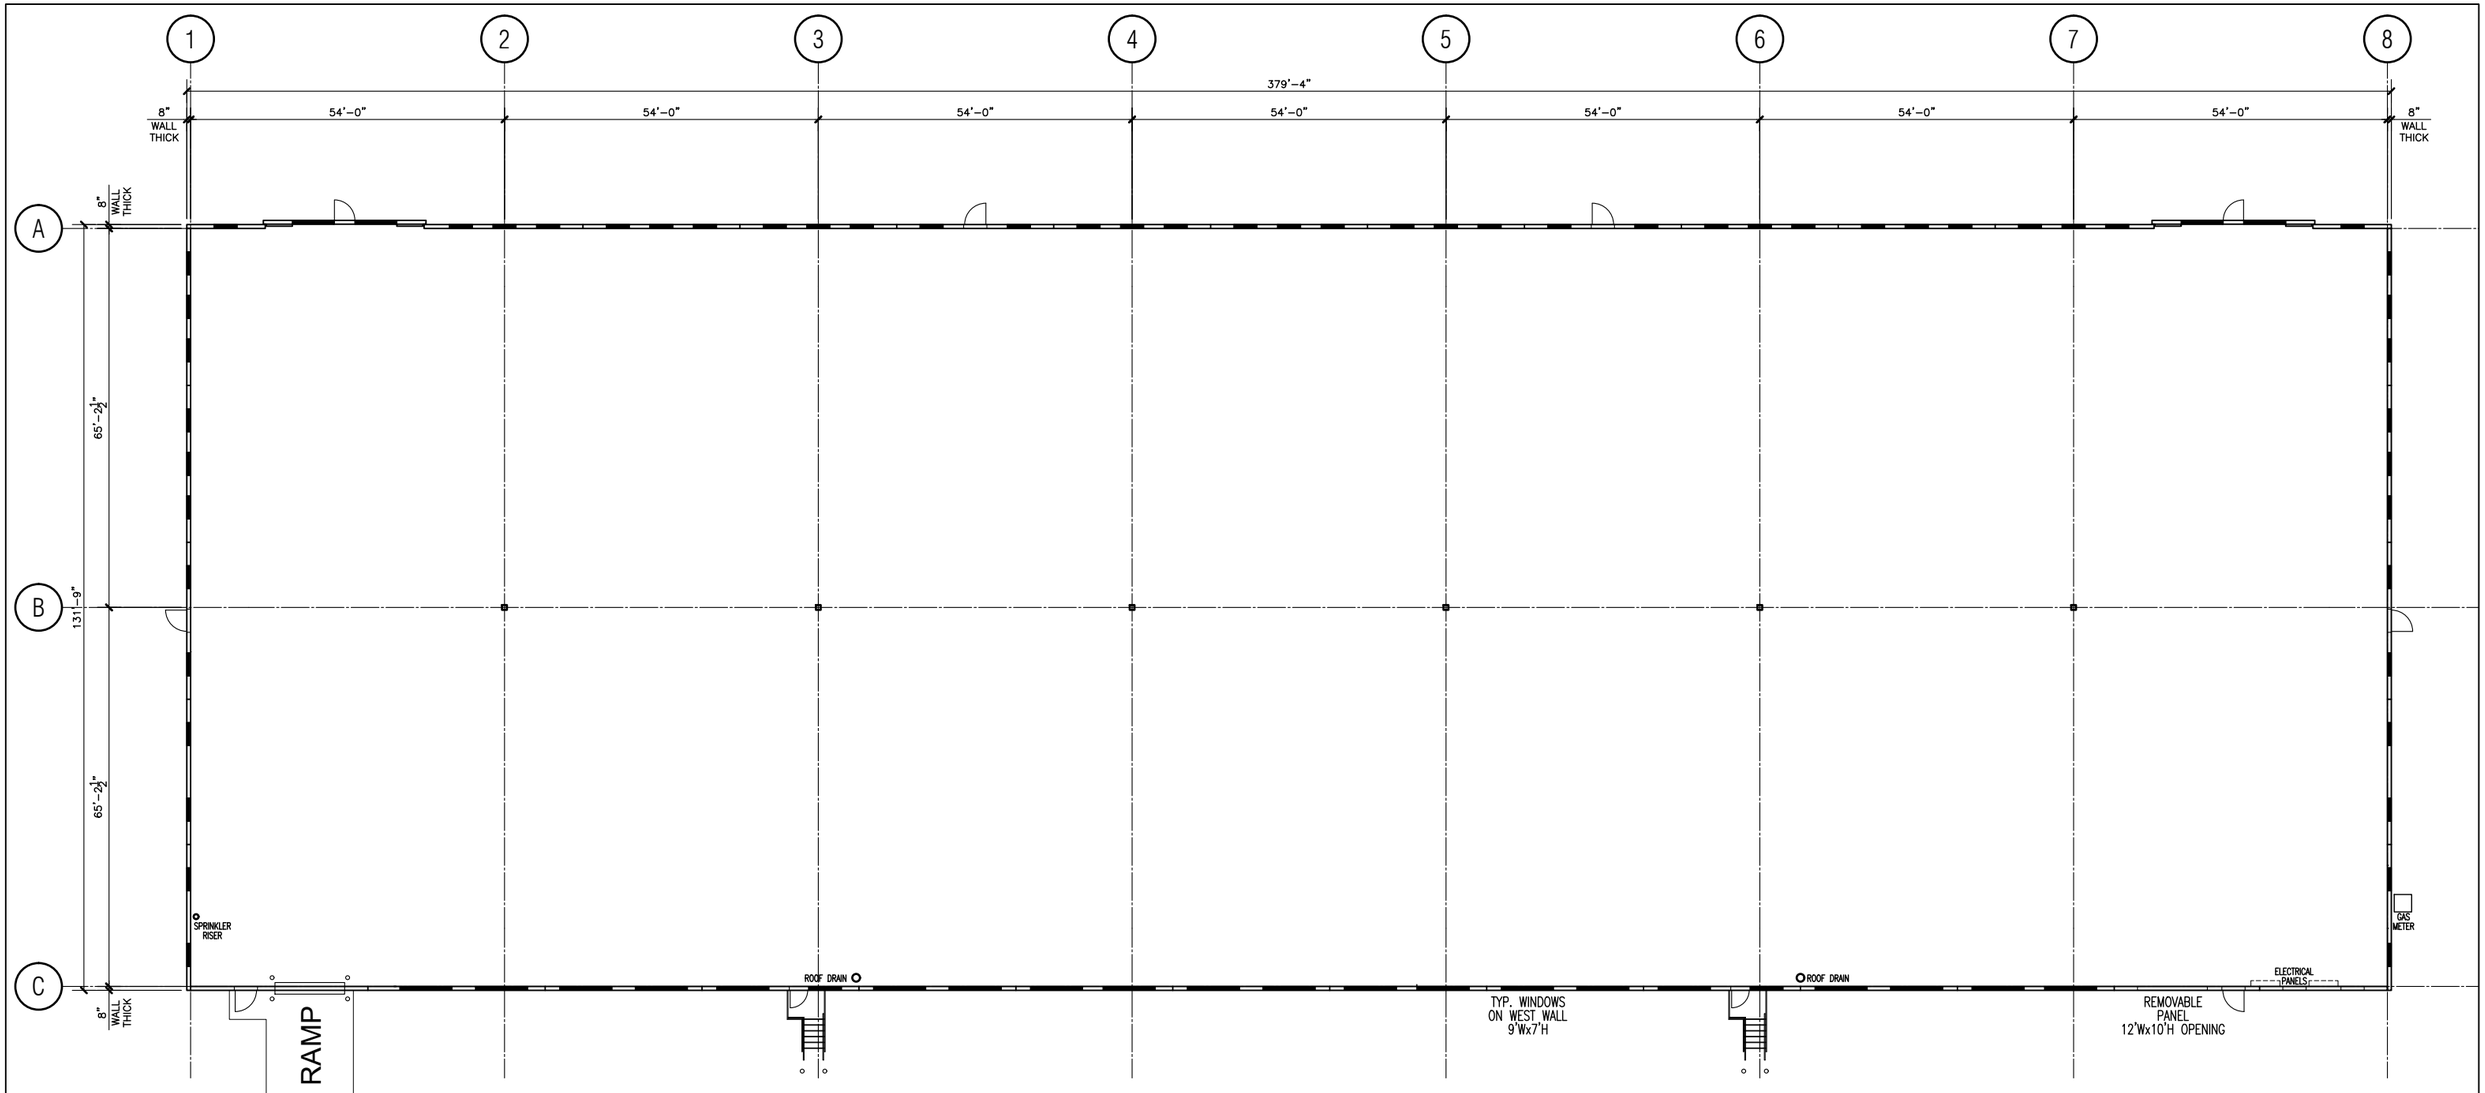

PROJECT NORTH

FLOOR PLAN

SCALE: N.T.S.

GREEN MOUNTAIN
CONSTRUCTION COMPANY, LTD.
17303 Green Mountain Rd.
Suite 100
San Antonio, TX 78247
210/495-1090
FAX: 210/495-1091

As Built Floor Plan for

GM-7 Building #1

Green Mountain Business Park

San Antonio, Texas

scale: N.T.S.

8 8 19

B1