

1761 SHIPMAN DR
San Antonio, Texas 78219
±11,287 SF – Up to ±28,837 SF Available



FOR LEASE

Distribution | Warehouse



CAVENDER & HILL
PROPERTIES

Property Details

- ±11,287 SF - ±28,837 SF Available
- Front-Loading Design
- 20' Clear Height
- Dock-High Loading
- End Cap Suite
- 10.0 mi (14 Min Drive) from San Antonio Intl Airport
- Excellent Access to IH-35, IH-410, and Loop 1604
- Ample Parking
- Concrete Tilt-Wall Construction




Hunter Z. Conger
210.323.3445
hconger@cavenderhill.com

Lee Jordan, SIOR
830.613.8324
ljordan@cavenderhill.com

Ford Douglass
210.557.7806
fdouglass@cavenderhill.com



Aerial

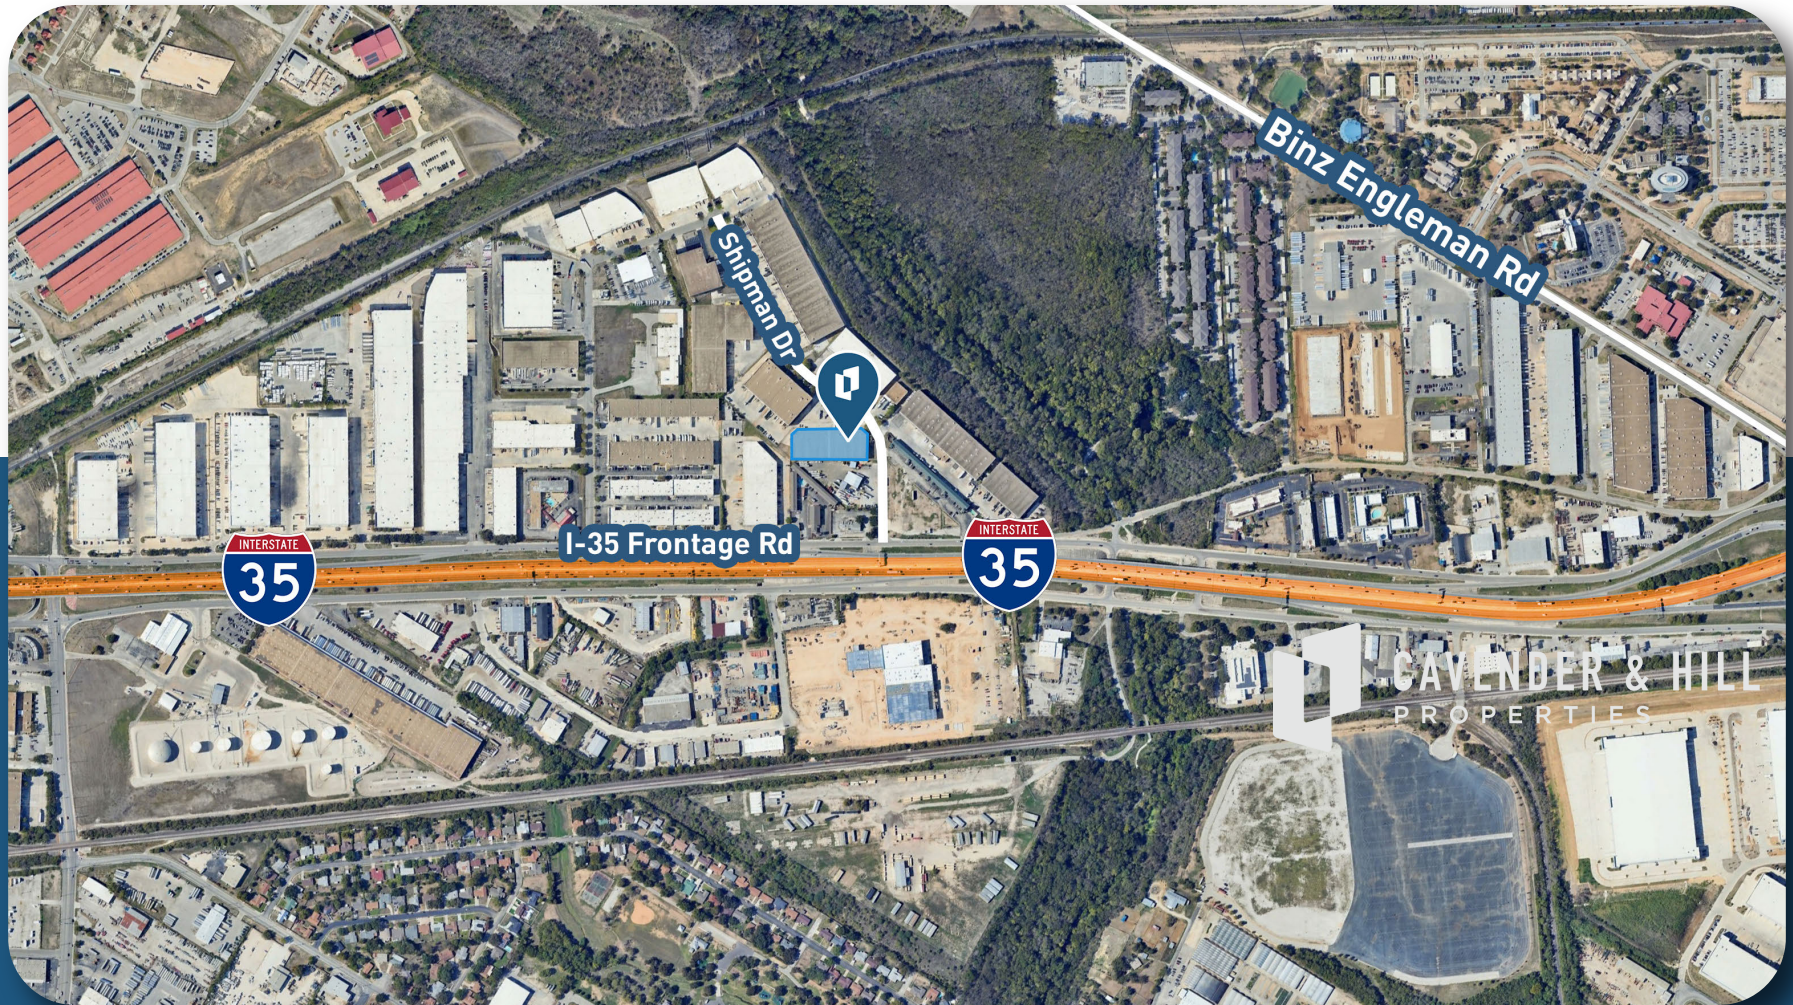


Hunter Z. Conger
210.323.3445
hconger@cavenderhill.com

Lee Jordan, SIOR
830.613.8324
ljordan@cavenderhill.com

Ford Douglass
210.557.7806
fdouglass@cavenderhill.com



Site Plan

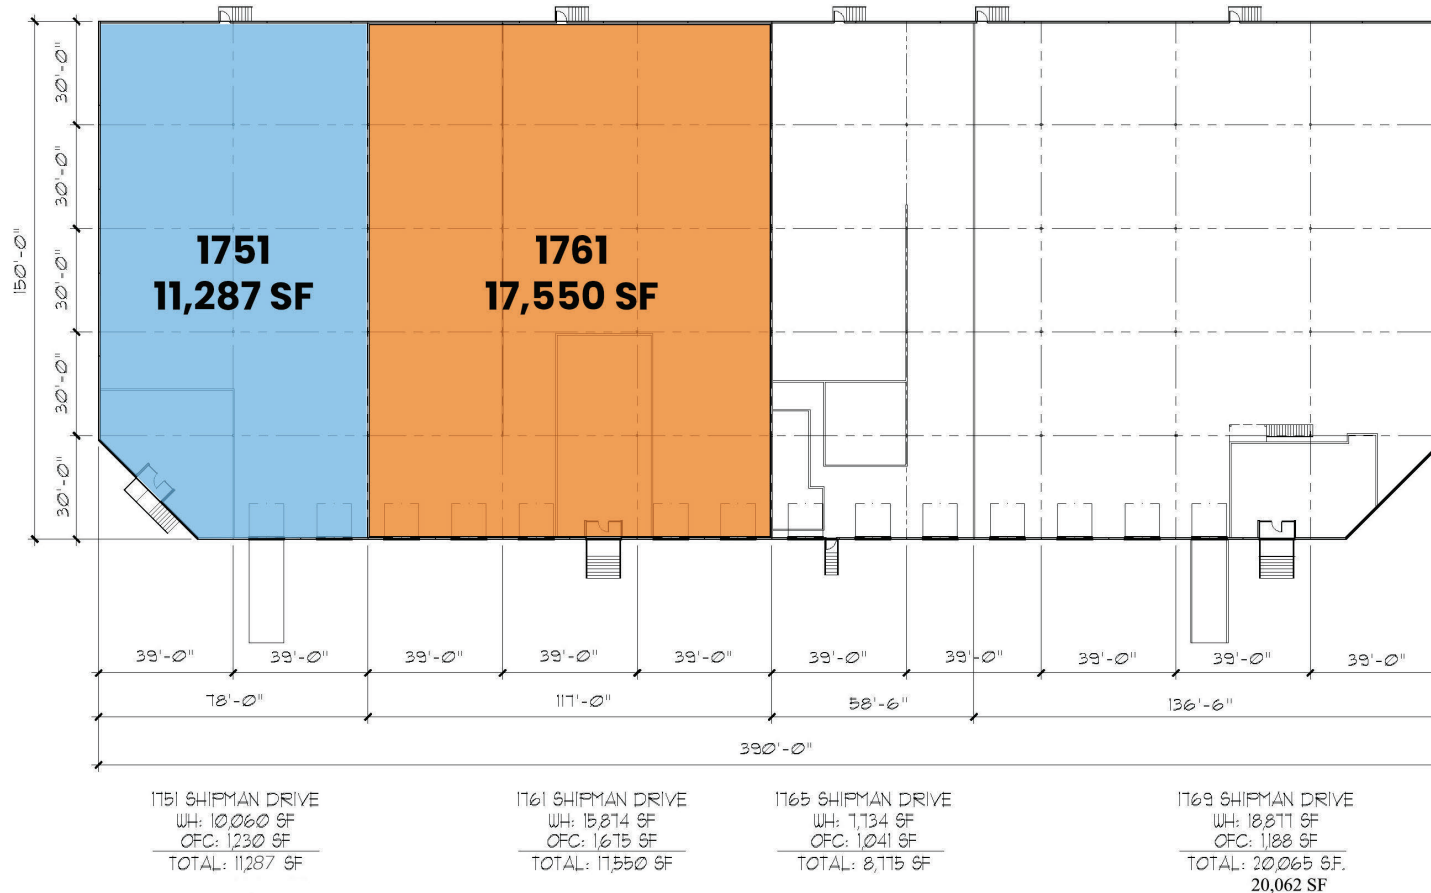

01 AS-BUILT FLOOR PLAN

SCALE: 1/32"=1'-0"



Hunter Z. Conger
210.323.3445
hconger@cavenderhill.com

Lee Jordan, SIOR
830.613.8324
ljordan@cavenderhill.com


Ford Douglass
210.557.7806
fdouglass@cavenderhill.com



Suite 1751 | 11,287 SF

Office: 1,230 SF

Warehouse: 10,060 SF

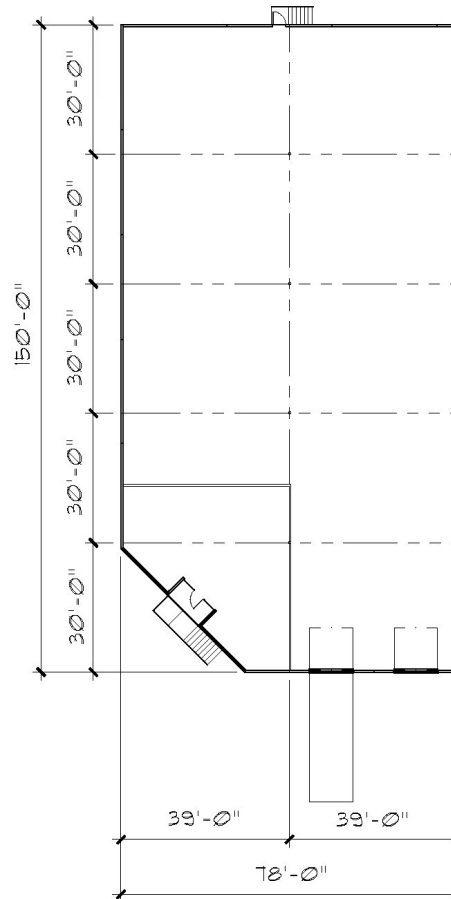

- 20' Clear Height
- Two (2) Dock-High Doors; One (1) With Ramp
- End Cap Suite




1761 SHIPMAN DR | SAN ANTONIO, TX 78219

Suite 1761 | 17,550 SF

Office: 1,675 SF

Warehouse: 15,874 SF

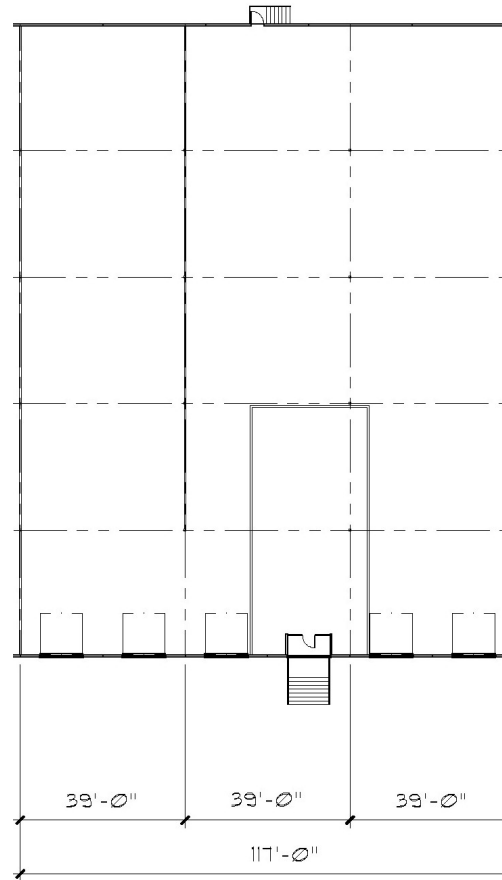

- 20' Clear Height
- Five (5) Dock-High Doors





Hunter Z. Conger
210.323.3445
hconger@cavenderhill.com

Lee Jordan, SIOR
830.613.8324
ljordan@cavenderhill.com

Ford Douglass
210.557.7806
fdouglass@cavenderhill.com



Information About Brokerage Services

Texas law requires all real estate license holders to give the following information about brokerage services to prospective buyers, tenants, sellers and landlords.

TYPES OF REAL ESTATE LICENSE HOLDERS

– **A BROKER** is responsible for all brokerage activities, including acts performed by sales agents sponsored by the broker.

– **A SALES AGENT** must be sponsored by a broker and works with clients on behalf of the broker.

A BROKER'S MINIMUM DUTIES REQUIRED BY LAW

(A client is the person or party that the broker represents)

Put the interests of the client above all others, including the broker's own interests;
Inform the client of any material information about the property or transaction received by the broker;
Answer the client's questions and present any offer to or counter-offer from the client; and
Treat all parties to a real estate transaction honestly and fairly.

LICENSE HOLDER CAN REPRESENT A PARTY IN A REAL ESTATE TRANSACTION

AS AGENT FOR OWNER (SELLER/LANDLORD):

The broker becomes the property owner's agent through an agreement with the owner, usually in a written listing to sell or property management agreement. An owner's agent must perform the broker's minimum duties above and must inform the owner of any material information about the property or transaction known by the agent, including information disclosed to the agent or subagent by the buyer or buyer's agent.

AS AGENT FOR BUYER/TENANT:

The broker becomes the buyer/tenant's agent by agreeing to represent the buyer, usually through a written representation agreement. A buyer's agent must perform the broker's minimum duties above and must inform the buyer of any material information about the property or transaction known by the agent, including information disclosed to the agent by the seller or seller's agent.

AS AGENT FOR BOTH - INTERMEDIARY:

To act as an intermediary between the parties the broker must first obtain the written agreement of each party to the transaction. The written agreement must state who will pay the broker and, in conspicuous bold or underlined print, set forth the broker's obligations as an intermediary. A broker who acts as an intermediary:

- Must treat all parties to the transaction impartially and fairly;
- May, with the parties' written consent, appoint a different license holder associated with the broker to each party (owner and buyer) to communicate with, provide opinions and advice to, and carry out the instructions of each party to the transaction.
- Must not, unless specifically authorized in writing to do so by the party, disclose:
 - that the owner will accept a price less than the written asking price;
 - that the buyer/tenant will pay a price greater than the price submitted in a written offer; and
 - any confidential information or any other information that a party specifically instructs the broker in writing not to disclose, unless required to do so by law.

AS SUBAGENT: A license holder acts as a subagent when aiding a buyer in a transaction without an agreement to represent the buyer. A subagent can assist the buyer but does not represent the buyer and must place the interests of the owner first.

TO AVOID DISPUTES, ALL AGREEMENTS BETWEEN YOU AND A BROKER SHOULD BE IN WRITING AND CLEARLY ESTABLISH:

- The broker's duties and responsibilities to you, and your obligations under the representation agreement.
- Who will pay the broker for services provided to you, when payment will be made and how the payment will be calculated.

LICENSE HOLDER CONTACT INFORMATION: This notice is being provided for information purposes. It does not create an obligation for you to use the broker's services. Please acknowledge receipt of this notice below and retain a copy for your records.

Cavender & Hill Properties, Inc. <small>Licensed Broker/Broker Firm Name or Primary Assumed Business Name</small>	438176 <small>License No.</small>	<small>Email</small>	(210) 349-0900 <small>Phone</small>
James Mark Cavender <small>Designated Broker of Firm</small>	40264 <small>License No.</small>	mcavender@cavenderhill.com <small>Email</small>	(210) 349-0900 <small>Phone</small>
<small>Licensed Supervisor of Sales Agent/ Associate</small>	<small>License No.</small>	<small>Email</small>	<small>Phone</small>
<small>Sales Agent/Associate's Name</small>	<small>License No.</small>	<small>Email</small>	<small>Phone</small>
<small>Buyer/Tenant/Seller</small>	<small>Landlord Initials</small>	<small>Date</small>	

Regulated by the Texas Real Estate Commission

Information available at www.trec.texas.gov

Cavender & Hill Properties, Inc. 7373 Broadway, Suite 501 San Antonio, TX 78209 **Phone.**210.349.0900 **Fax.**210.349.0931