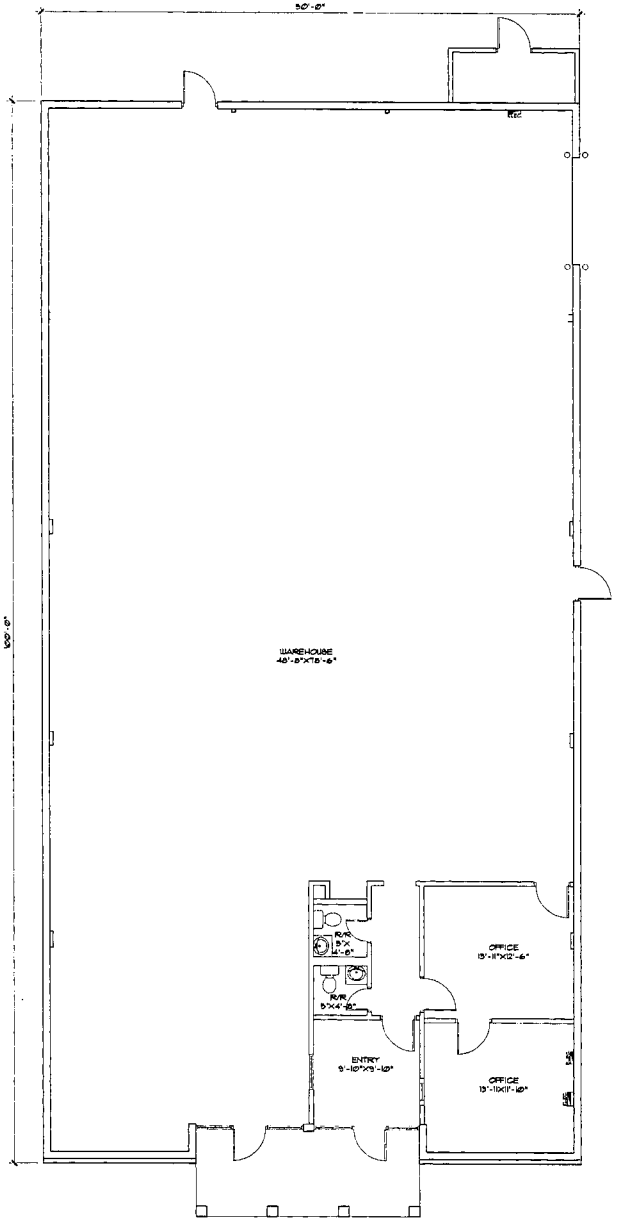

01 AS-BUILT FLOOR PLAN-5,000 SF

SCALE: 3/16"=1'-0"

NORTH

ALL DIMENSIONS ARE APPROXIMATE AND ALL INFORMATION IS OF GENERAL NATURE

AB1-110920

REVISIONS DATE	#

These drawings and accompanying specifications are at all or bestowed to, owned and shall remain the property of the Architect. They are not to be used on other projects or extensions to this project except by agreement in writing and with appropriate compensation to the Architect. Contractor is responsible for confirming and correlating dimensions in the job site, the Architect will not be responsible for construction means, methods, techniques, sequences or procedures, or for safety precautions and programs in connection with the project.

VILLA PARK
ARCHITECTURE/PLANNING/INTERIORS,PLLC
300 W. BITTERS ROAD, SUITE 204
SAN ANTONIO, TX. 78216
VOICE: (210) 384-8900
FAX: (210) 384-8240
EMAIL: MARK@VILLAPARK-SA.COM

© 2020 ALL RIGHTS RESERVED

NOT FOR REGULATORY APPROVAL, PERMITTING OR CONSTRUCTION

AS-BUILT FLOOR PLAN

1011 PAULSUN DRIVE
SAN ANTONIO, TEXAS 78219

DRAWN	TDM
CHECKED	MDN
DATE	11/10/20
PROJECT	1011 PAULSUN
JOB. NO.	20-274
SHEET	AB1