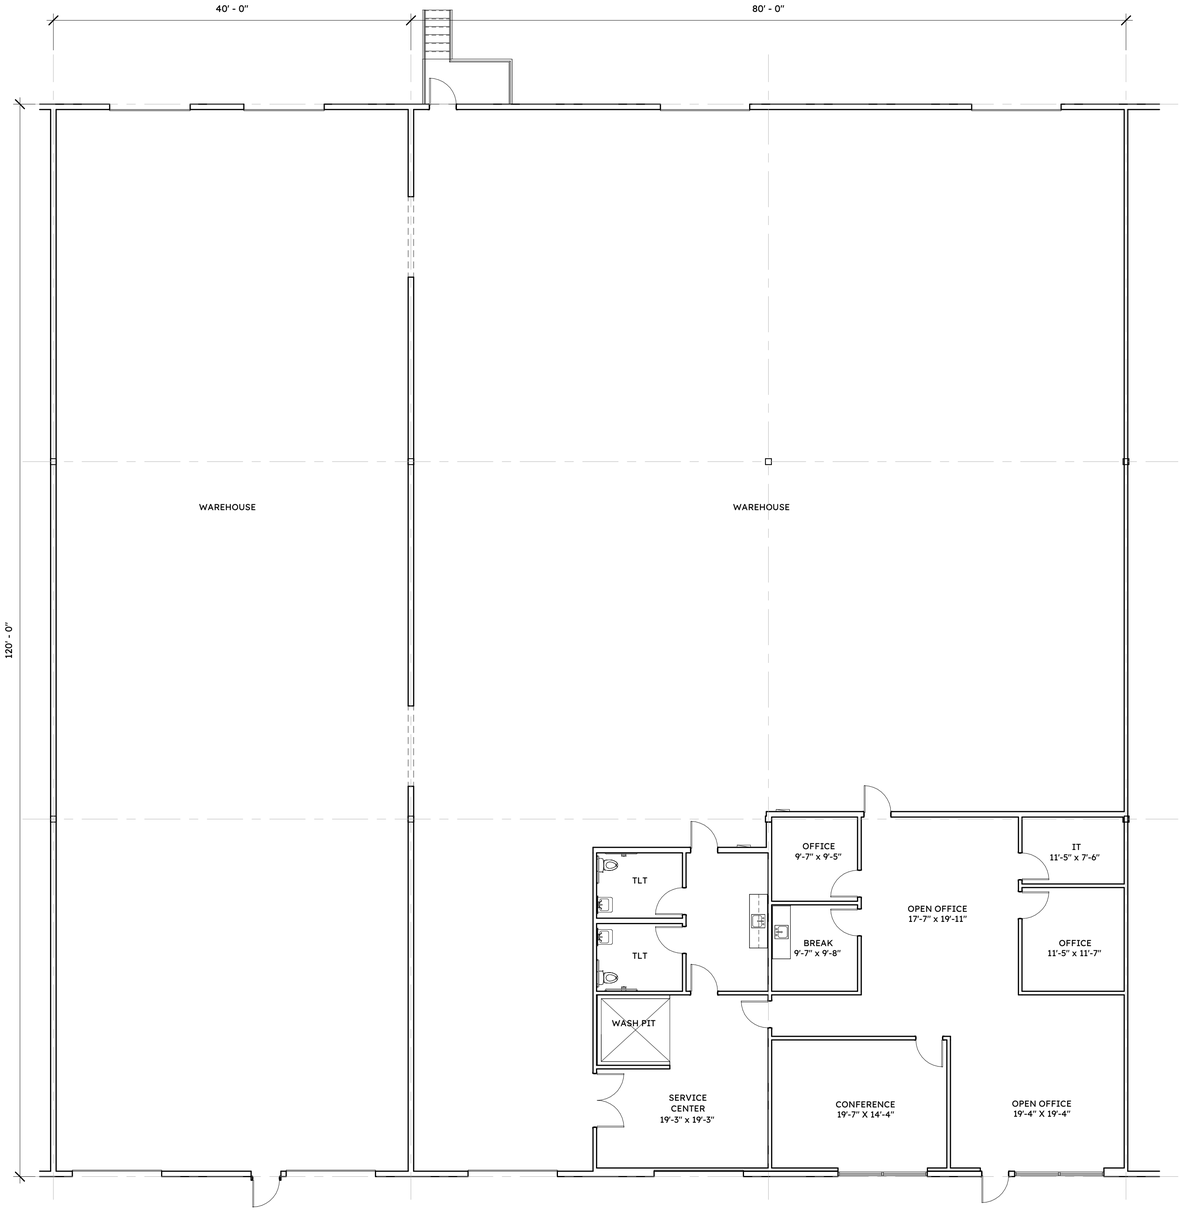

1 As-Built Plan
1/8" = 1'-0"

12871-12875 Wetmore Rd - As-Built Plan

Wetmore Business Park
12871-12875 Wetmore Road
San Antonio Texas

11/13/2026

Scale: 1/8" = 1'-0"

LKDG Prj. No: 26230

lk design group
architecture planning interiors